


T. 14S. R. 2W. W.M.

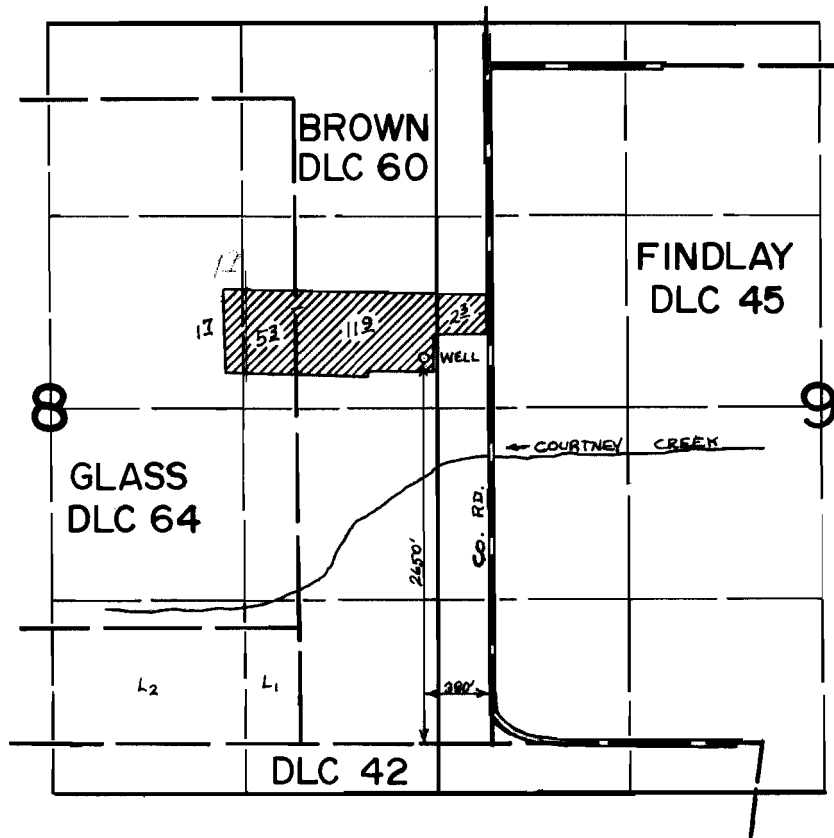

FINAL PROOF SURVEY
UNDER

Application No. G-4746 Permit No. G-4465
IN NAME OF

LARRY A. HIGLEY

Surveyed AUG. 8 1974, by D. NORBY