


T.11S., R.2W., W.M.

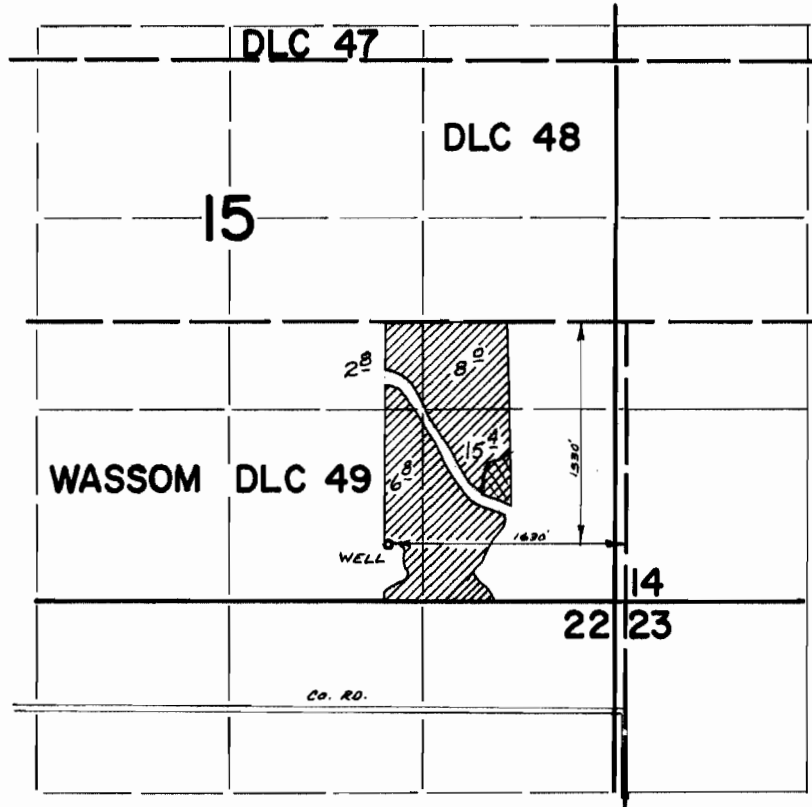

**FINAL PROOF SURVEY**  
UNDER

Application No. G-4998 Permit No. G-4716  
IN NAME OF

LOUREE CUNNINGHAM

Surveyed April 4 1974, by S.P. Applegate