


T.14S.,R.1E.,W.M.

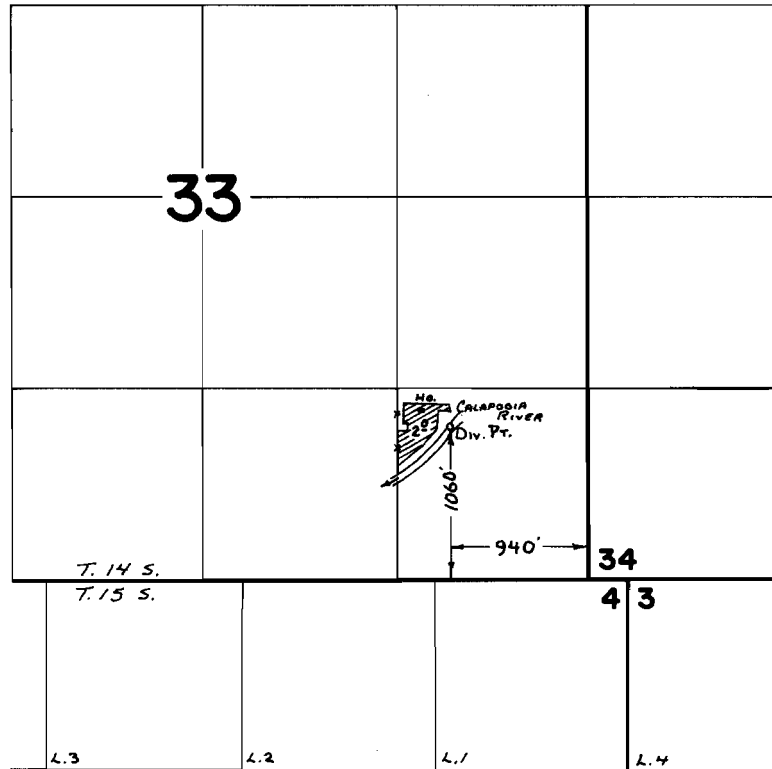

FINAL PROOF SURVEY
UNDER

Application No. 43895 Permit No. 32811
IN NAME OF

HAROLD F. & MILDRED BIRDSALL

Surveyed July 1 1974, by L. T. T. T.