


T.12&13S.,R.1W.,W.M.

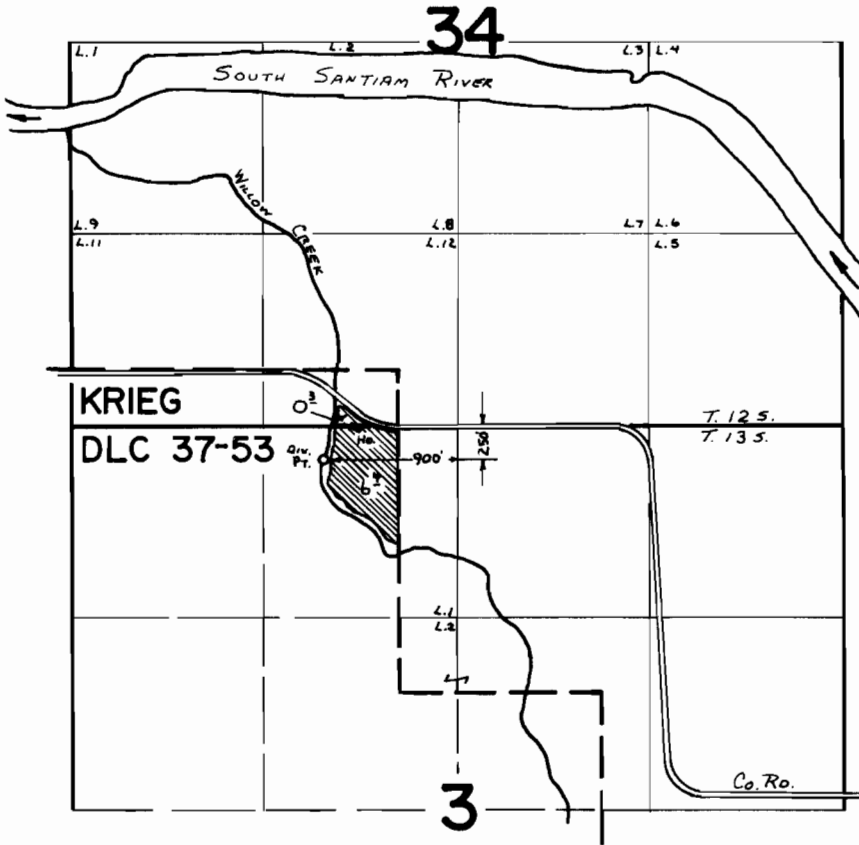

FINAL PROOF SURVEY
UNDER

Application No. 45393 Permit No. 33892
IN NAME OF

HENRY L. & EILEEN L. ERDWINS

Surveyed Oct. 17 1974, by L. Telle