


T.10S., R. 3 W., W.M.

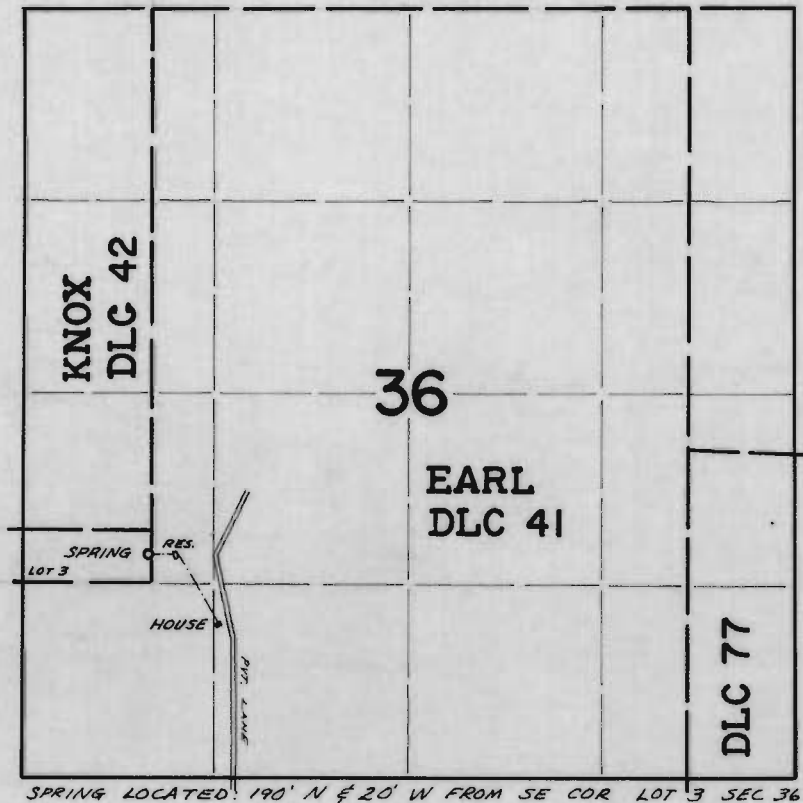

FINAL PROOF SURVEY
UNDER

Application No. 49459 Permit No. 37048
IN NAME OF

GEORGE L. LINES

Surveyed April 4, 1974, by S.P. Applegate