


T.7S. R.2W. W.M.

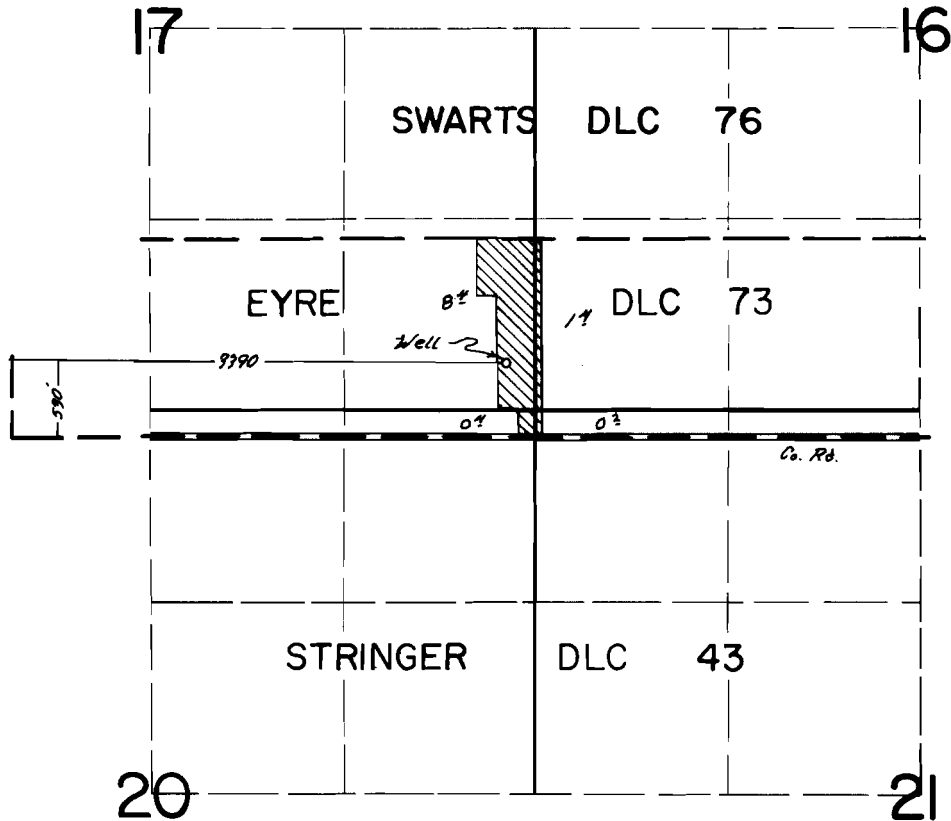

**FINAL PROOF SURVEY**  
UNDER

Application No. G-5022 Permit No. G-4603  
IN NAME OF

JOANN & RAY RITSON

Surveyed June 1 1973, by T. J. Paul