


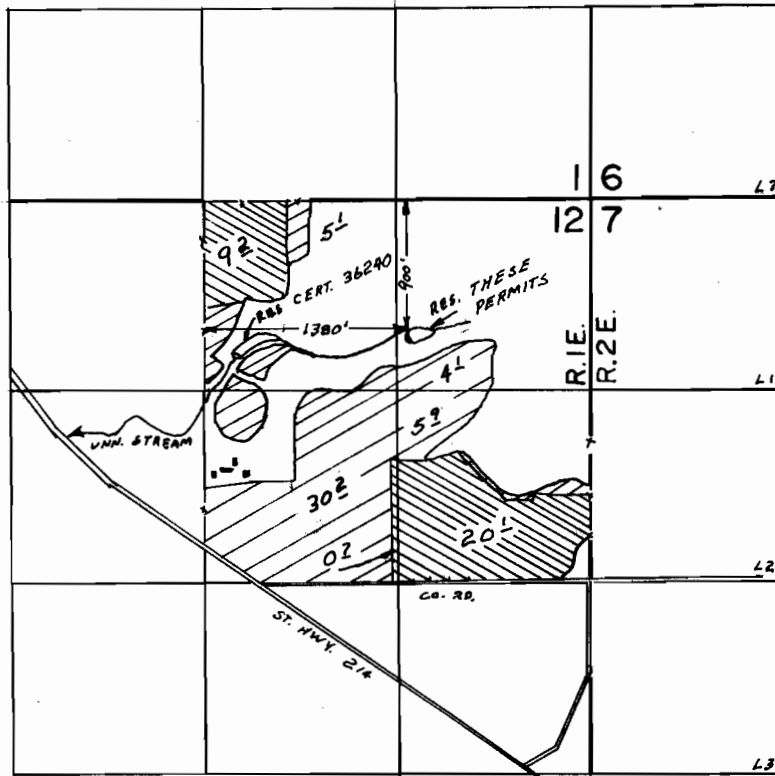

T.8S. R.1E. W.M.

copy
map from file
5-44197



 ALLOWED THESE PERMITS
 NOT ALLOWED

FINAL PROOF SURVEY
UNDER

R-44196 R- 4978
Application No. 44197 Permit No. 32430
IN NAME OF

ANTHONY DE SANTIS

Surveyed MAY 30 1974, by LH NUNN