Copy
map from file
5-44197

T.8S. R.1E. W.M.

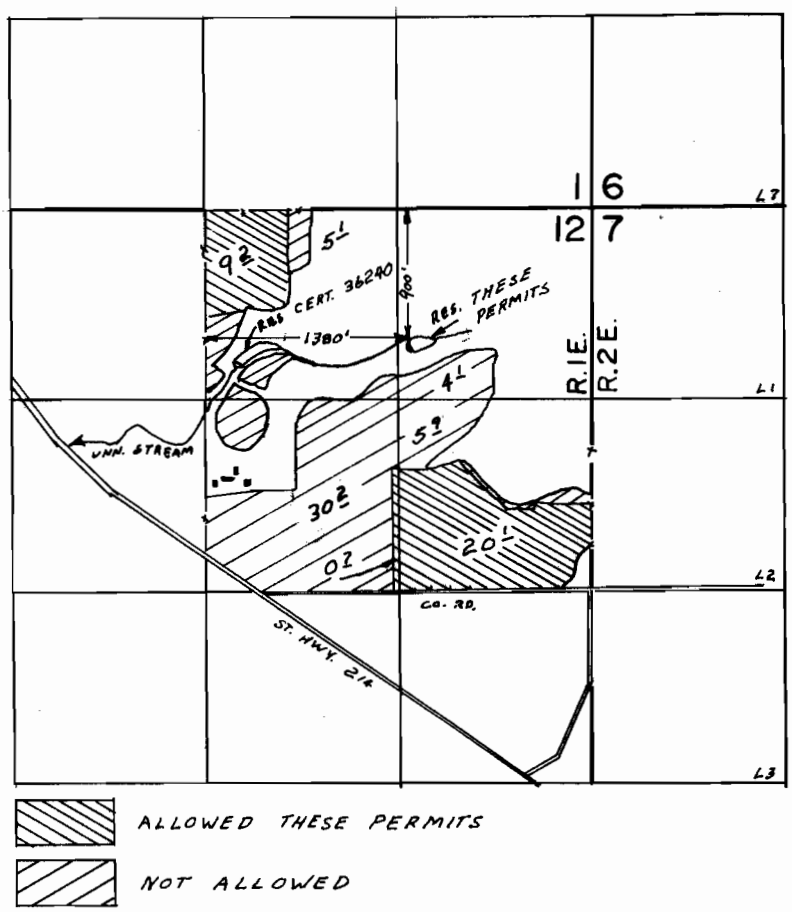

FINAL PROOF SURVEY
UNDER

R-44196 R-4978
Application No. 44197 Permit No. 32430
IN NAME OF

ANTHONY DE SANTIS

Surveyed MAY 30 1974, by LH NUNN

DFN-4LL-172 LHN