


T.68&7S. R.5W. W.M.

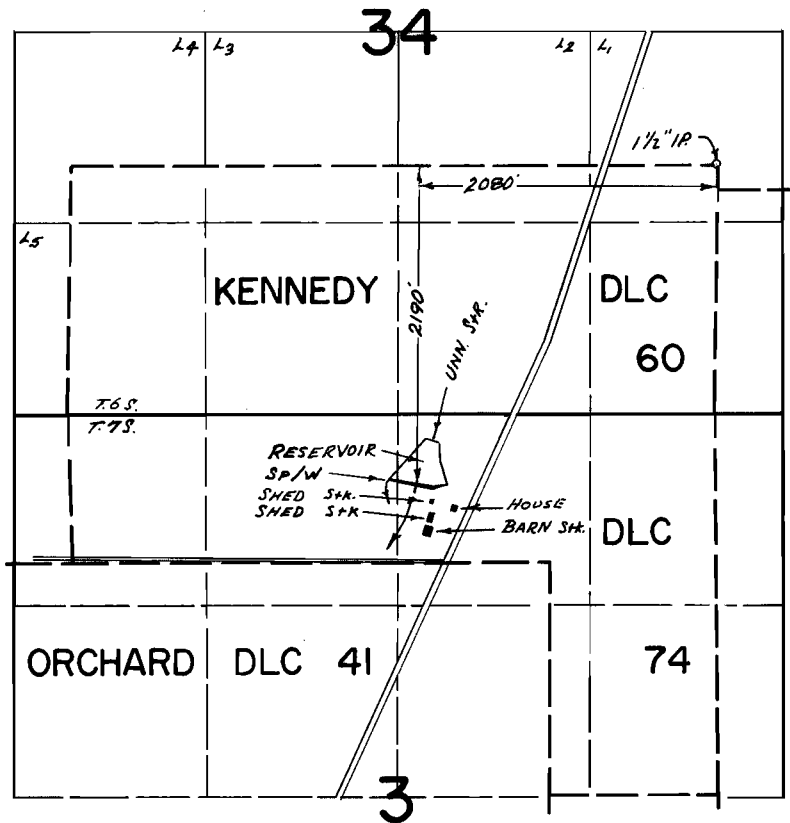

FINAL PROOF SURVEY
UNDER

R-48844 R-5929
Application No.48845 Permit No.36603
IN NAME OF

.....WAYNE HIEBENTHAL.....

Surveyed April 25 1974, by T. J. PAUL.....