


T.68&7S. R.5W. W.M.

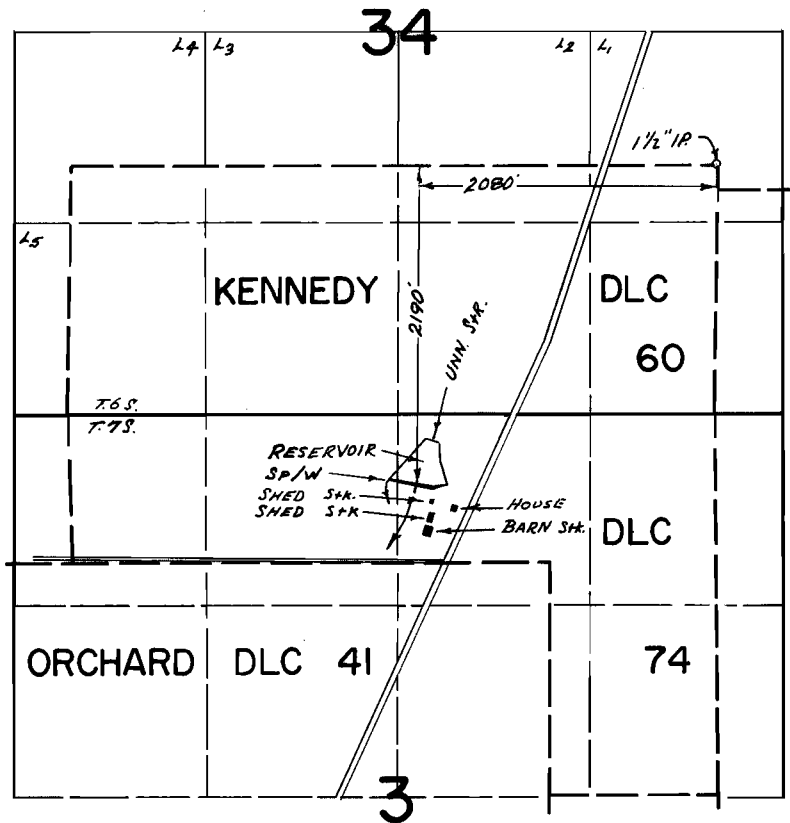

**FINAL PROOF SURVEY**  
UNDER

R-48844                      R-5929  
Application No. ....48845 Permit No. ....36603  
IN NAME OF

.....WAYNE HIEBENTHAL.....

Surveyed April 25 1974, by T. J. PAUL.....