


T.6S. R.7W. W.M.

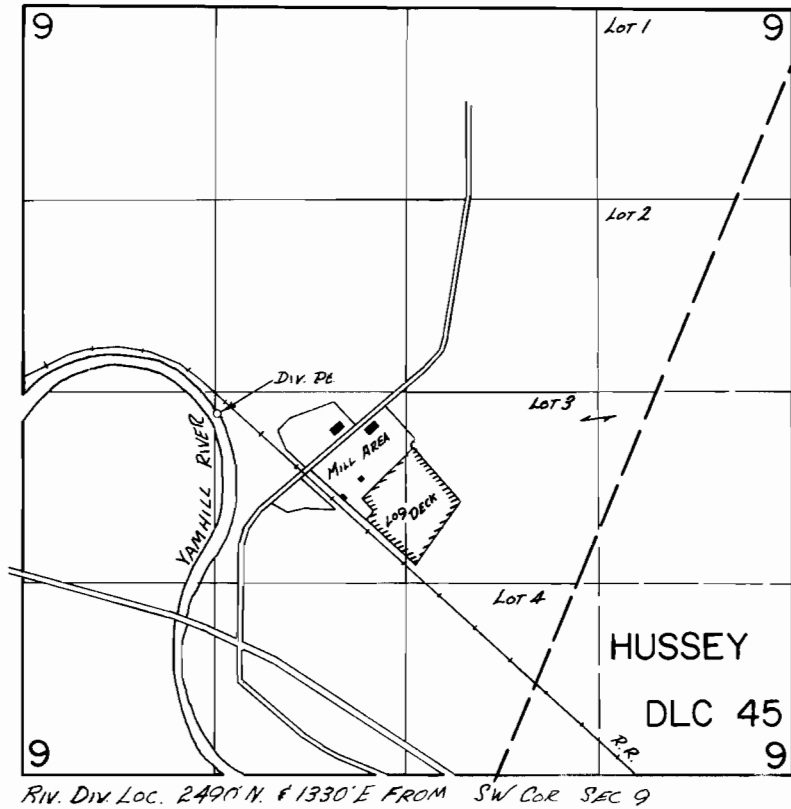

FINAL PROOF SURVEY
UNDER

Application No. 49564... Permit No. 36783...
IN NAME OF

FORT HILL LUMBER COMPANY

Surveyed Oct. 8, 1974, by T. J. PAUL