


T.4S., R.3W., W.M.

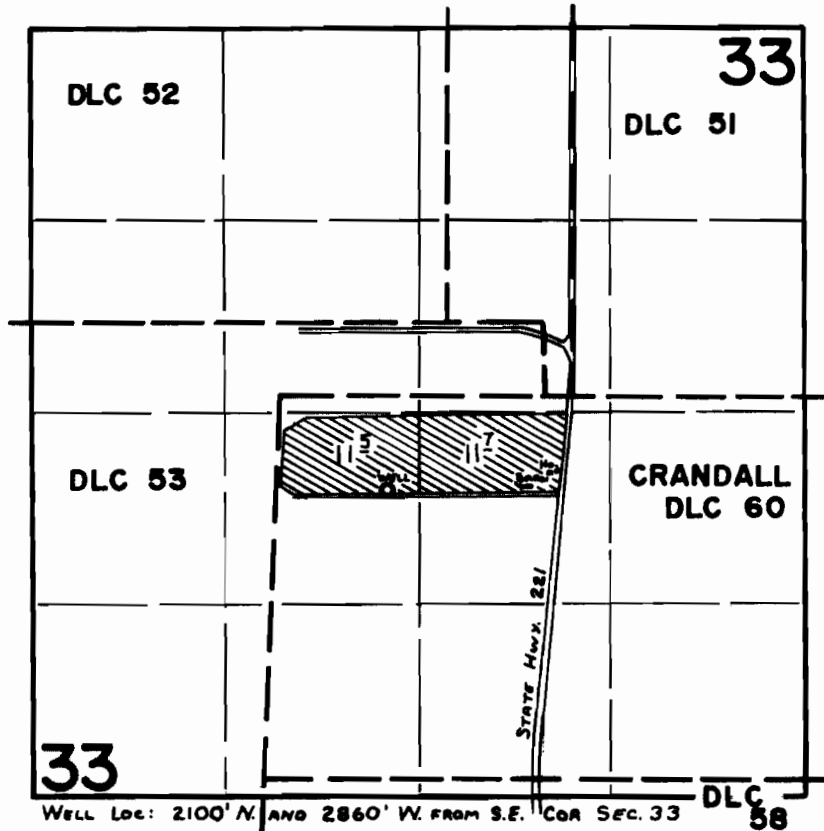

FINAL PROOF SURVEY UNDER

Application No. ~~G-3898~~ Permit No. ~~G-3663~~
IN NAME OF

LEONARD DOOLEY

Surveyed July 25 1974, by L. Toll