


T.5S.R.6W.W.M.

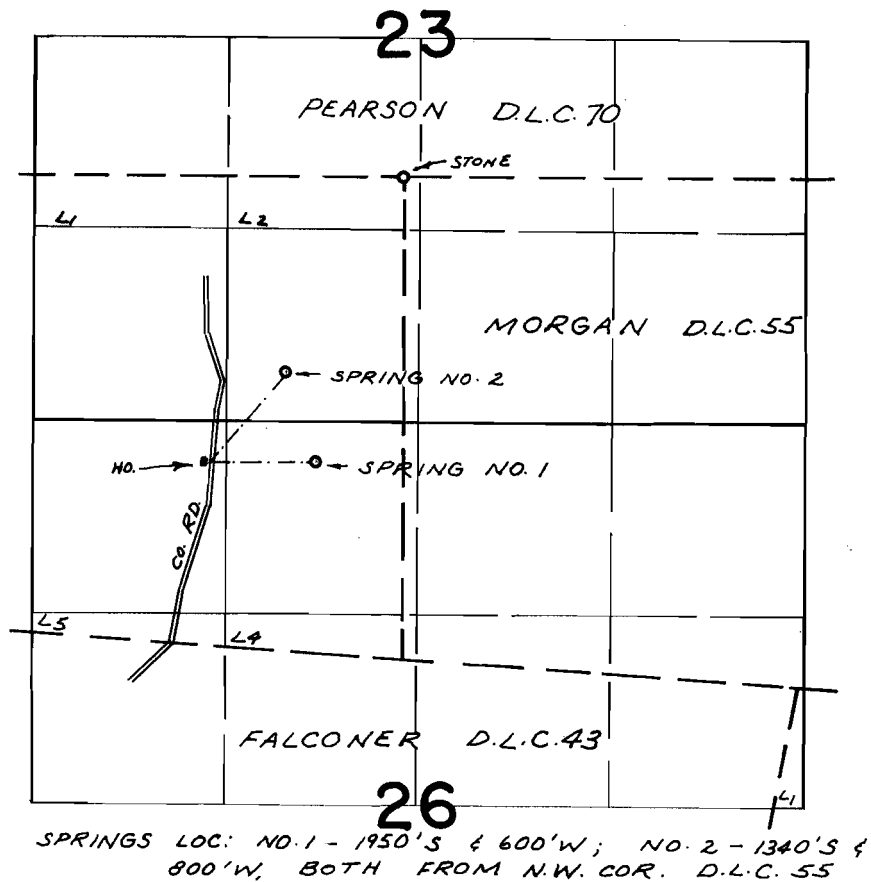

FINAL PROOF SURVEY
UNDER

Application No. 43863 Permit No. 32776
IN NAME OF

MARC W. MECKES

Surveyed MAY 1, 1974, by L. E. GOULD