


T.4S.,R.4W.,W.M.

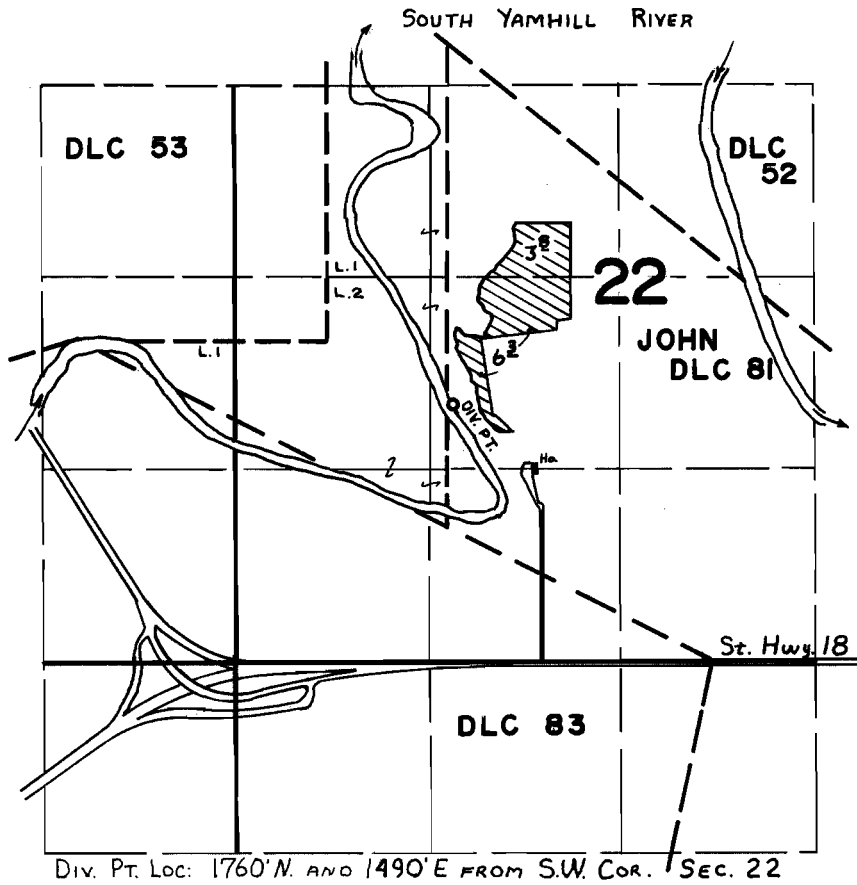

FINAL PROOF SURVEY
UNDER

Application No. 44274 Permit No. 33071
IN NAME OF

DR. GEORGE A. DUNN

Surveyed JULY 24 1974, by L. TOLL