


T.12S., R.5W., W.M.

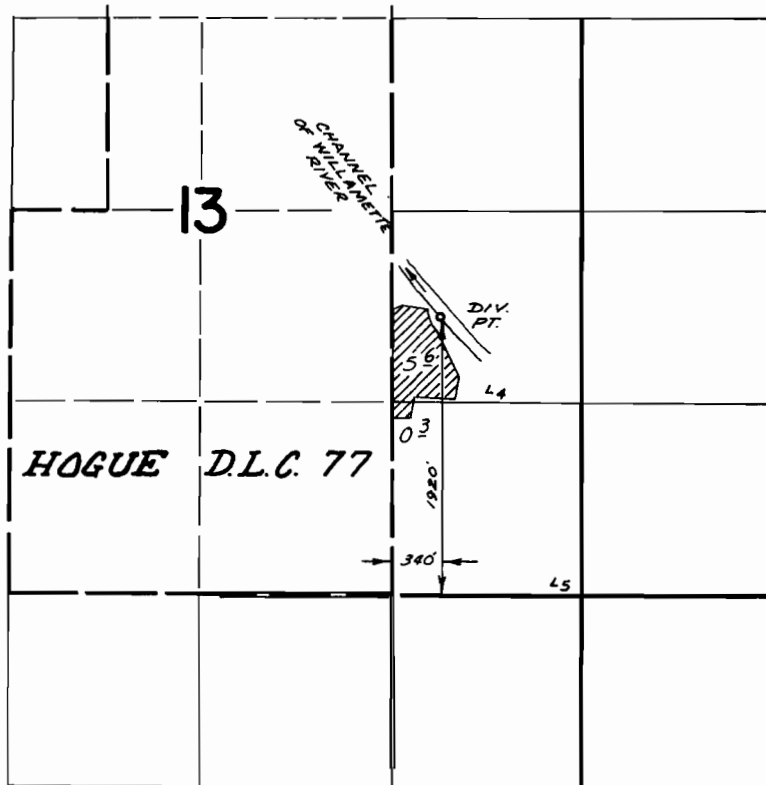

FINAL PROOF SURVEY
UNDER

Application No. 42277 Permit No. 31620
IN NAME OF

JAMES C. HATHAWAY

Surveyed June 6 1973, by D. Norby