


# T. 3 S. R. 1 W. W.M.

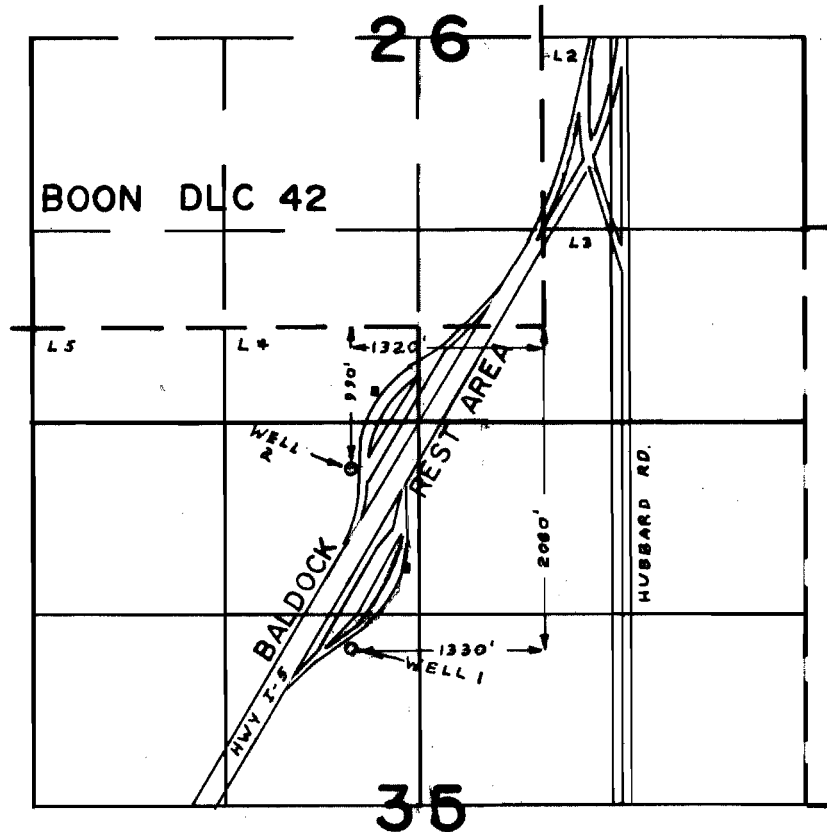

## FINAL PROOF SURVEY UNDER

Application No. G-3254. Permit No. G-2951.....  
IN NAME OF

OREGON STATE HIGHWAY COMMISSION.

Surveyed AUG. 13. 1974, by L.H. NUNN.....