T. 2 S. R 3 E. W.M.

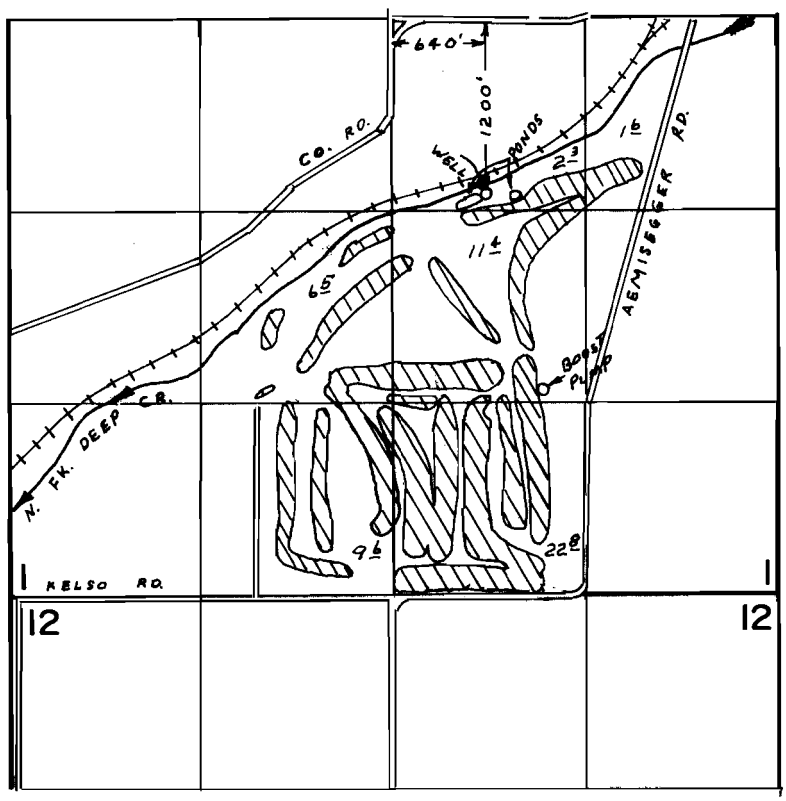

FINAL PROOF SURVEY
UNDER

Application No. G-3865 Permit No. G-3826
IN NAME OF

MOUNTIAN VIEW PUBLIC GOLF COURSE, INCORPORATED

Surveyed NOV 4 1974, by L.H. NUNN

DFK-1LL-75 LHN