


# T. 3 S. R. 1 W. W.M.

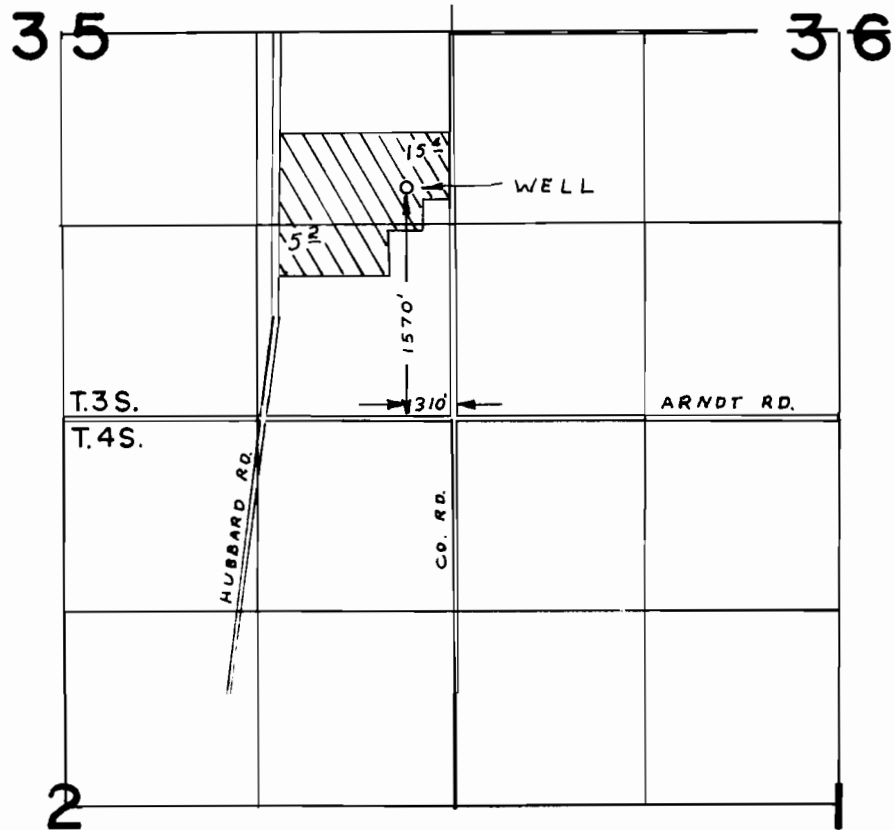

## FINAL PROOF SURVEY UNDER

Application No. G-4374 Permit No. G-4126  
IN NAME OF

CROWN ZELLERBACH CORP.

Surveyed AUG. 14, 1974, by L.H. NUNN