


# T.3S. R.1E. W.M.

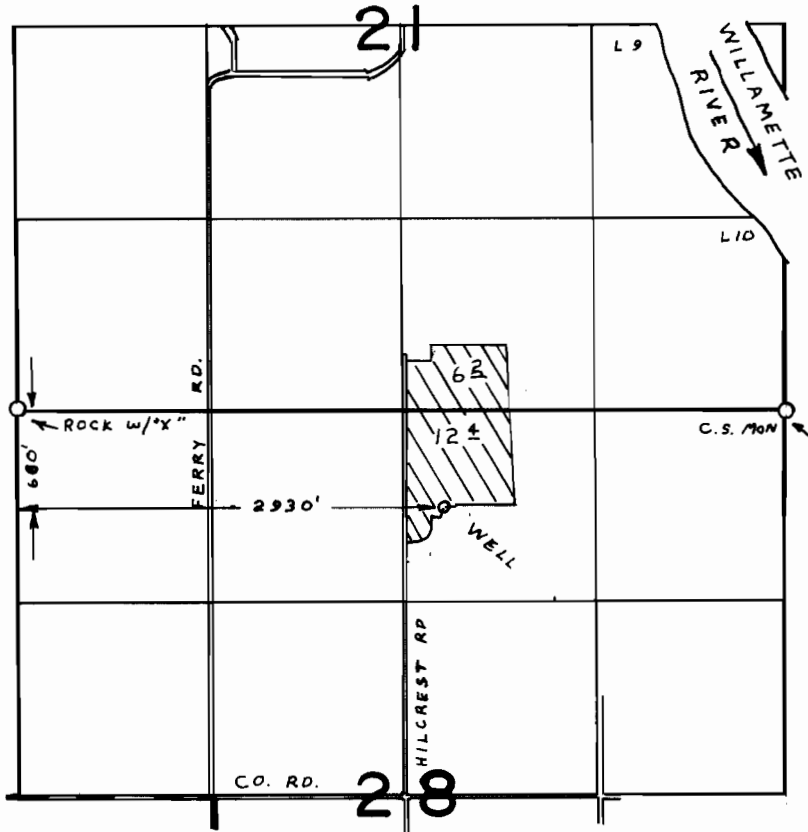

## FINAL PROOF SURVEY UNDER

Application No. G-4620 Permit No. G-4346  
IN NAME OF

GORDON ANDRUS

Surveyed AUG. 15 1974, by L.H. NUNN