


T.3 S. R.4 E. W.M.

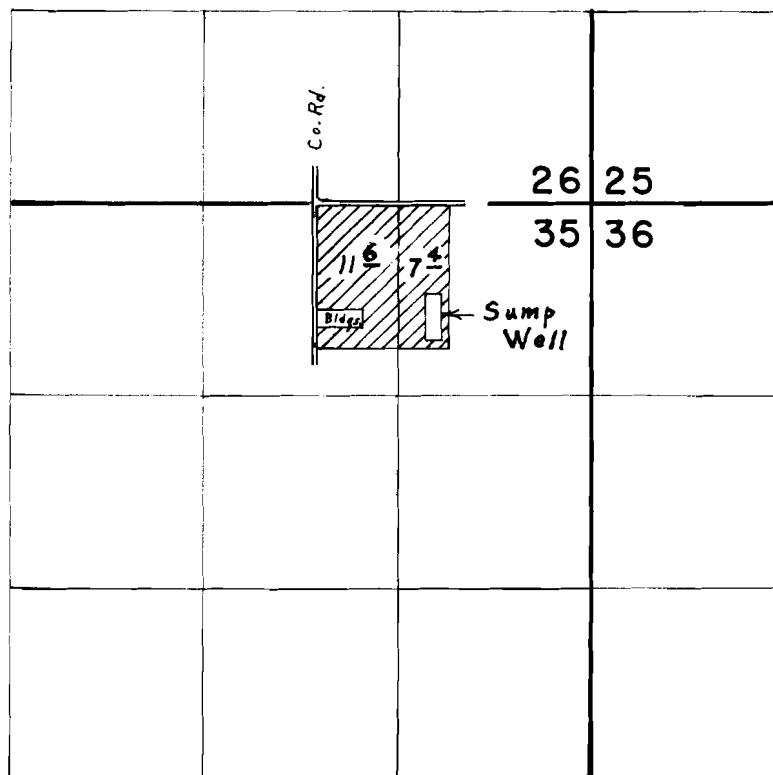

Well located 790' S. & 1080' W. from N. E. Cor. Sec. 35

FINAL PROOF SURVEY

UNDER

Application No. G-5225 Permit No. G-4834

IN NAME OF

PAUL WHEELER

Surveyed Aug. 28, 1975, by L. E. Gould