


T.5S., R.1E., W.M.

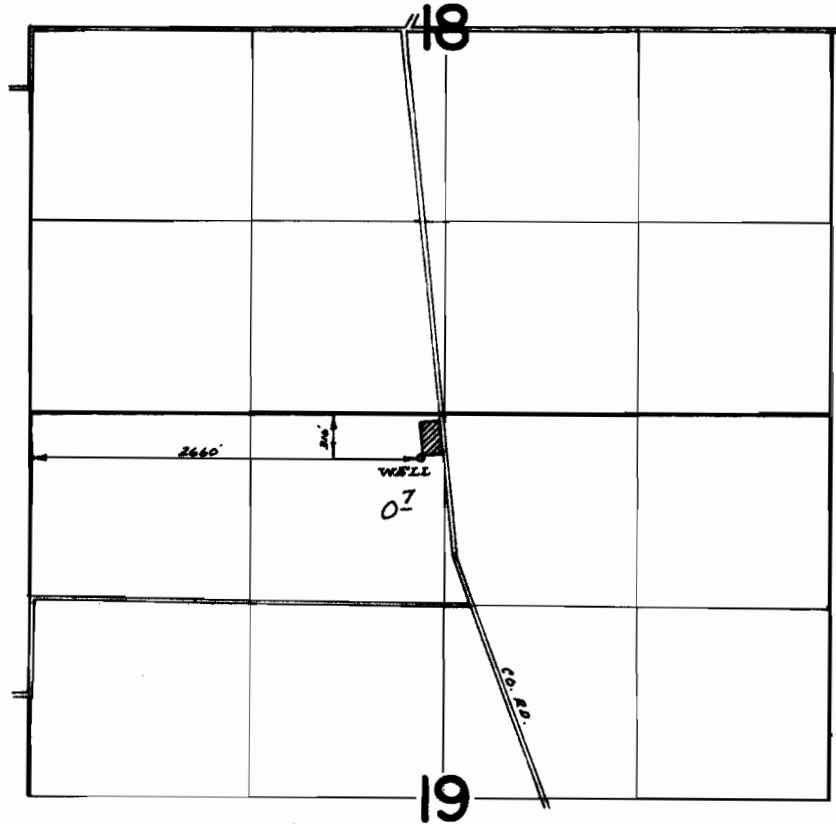

FINAL PROOF SURVEY
UNDER

Application No. G-5824 Permit No. G-5157
IN NAME OF

DON CLINE

Surveyed Aug. 30, 1974, by D. Dorby