


T.5S., R.2E., W.M.

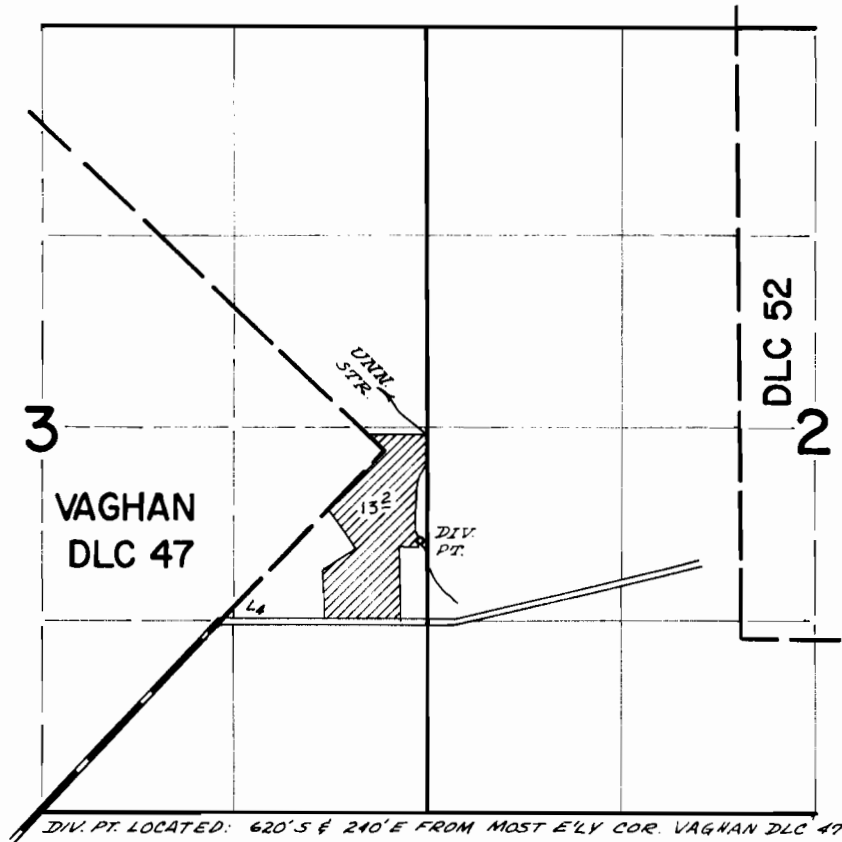

FINAL PROOF SURVEY
UNDER

Application No. 42819 Permit No. 31453
IN NAME OF

JOSEPH F. AND LOIS L. DURFEE

Surveyed Sept. 20 1974, by D. Dorby