


T.4S., R.2E., W.M.

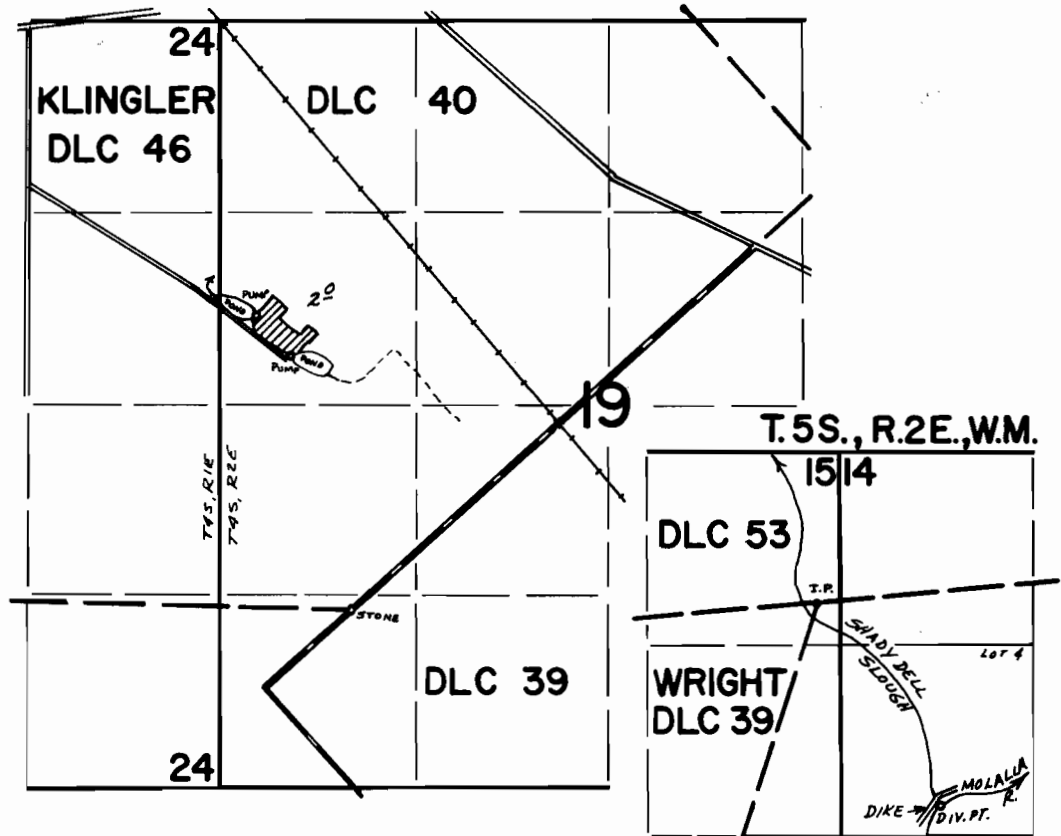

DIV. PT. LOCATED: 1390'S & 850' E FROM NE COR WRIGHT DLC 39.

FINAL PROOF SURVEY UNDER

Application No. 46247 Permit No. 34552
IN NAME OF

MRS. RONALD A. SHAPLAND

Surveyed Sept. 4 1974, by