


T. 4S. R. 3E. W. M.

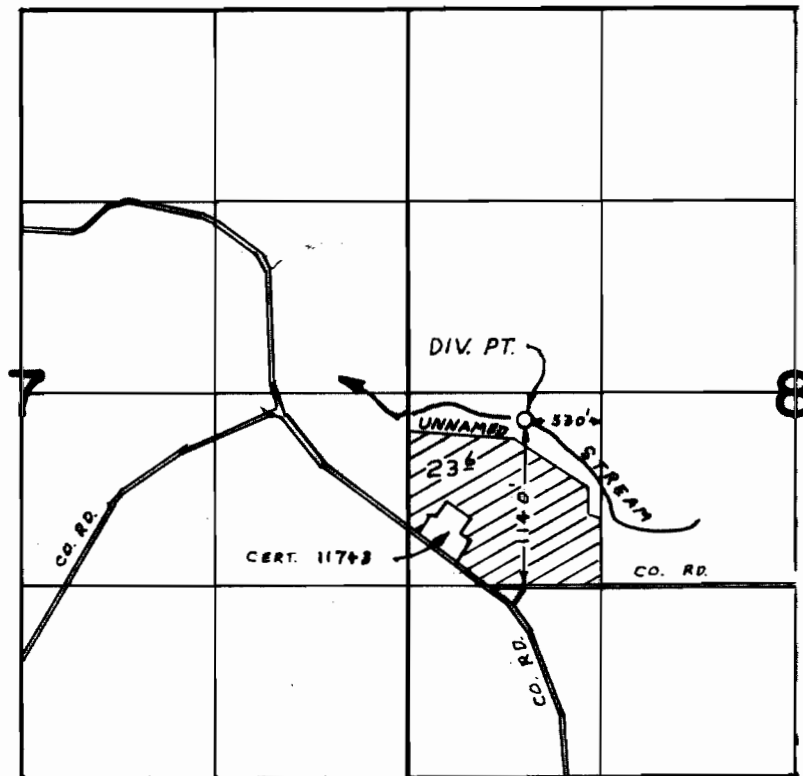

FINAL PROOF SURVEY
UNDER

Application No. 46601 Permit No. 34827
IN NAME OF

ROY E. HENRICI

Surveyed SEPT. 27 1974, by L.H. NUNN