


T. 4 S. R. 2 E. W.M.

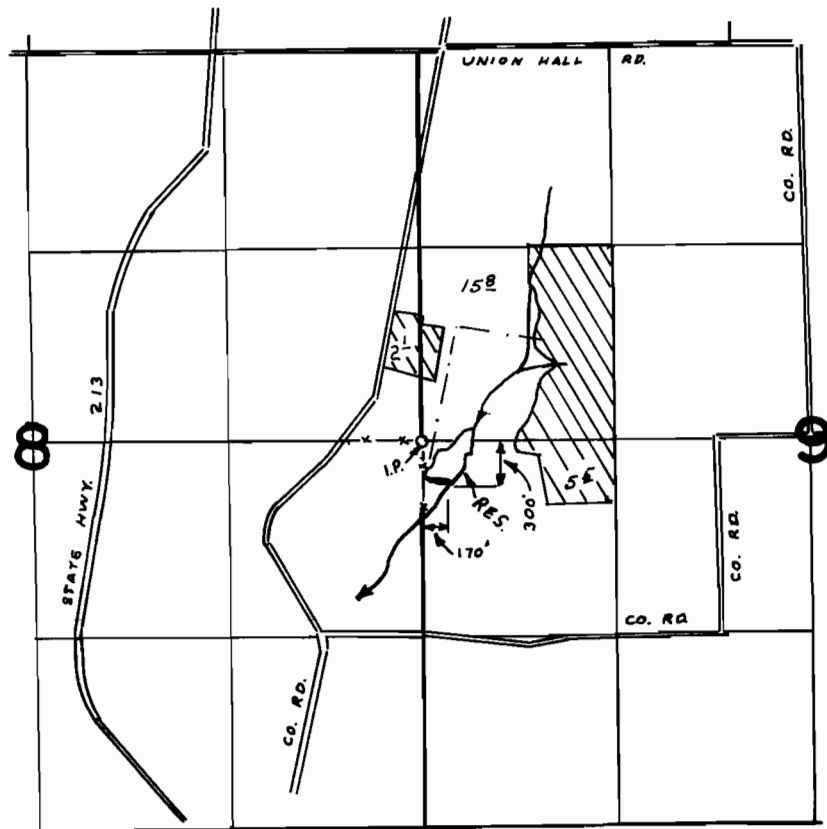

FINAL PROOF SURVEY
UNDER

R-47351 R-5581
Application No. 47352 Permit No. 34883
IN NAME OF

WILLIAM H. DAY

Surveyed OCT. 8, 1974, by L. H. NUNN