


T.3S.R.1W.W.M.

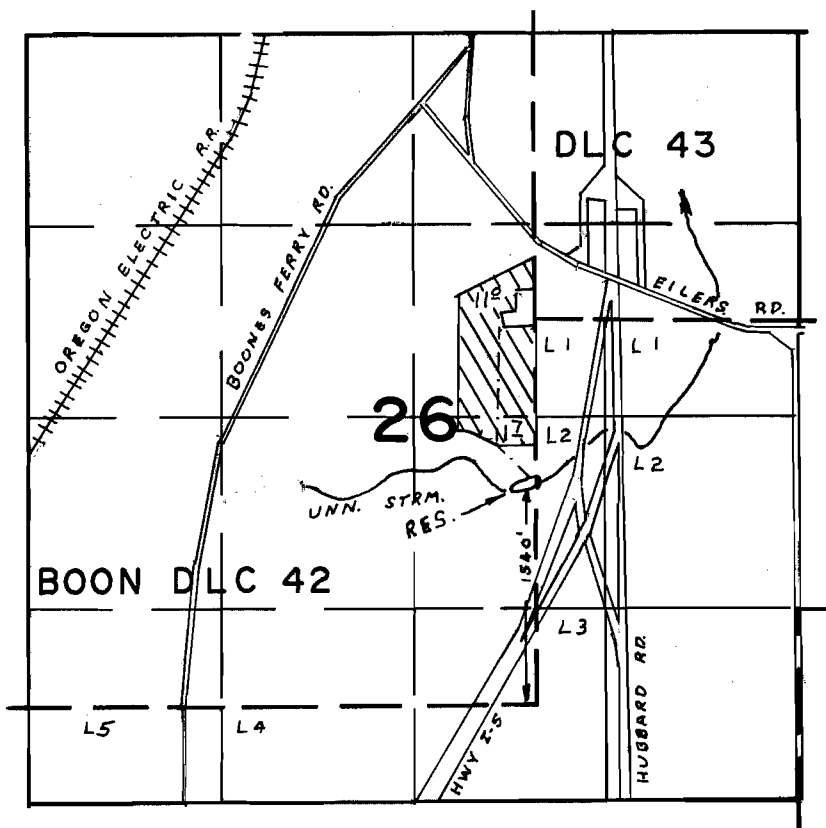

FINAL PROOF SURVEY UNDER

R-47871 R-5668
Application No. 47872 Permit No. 35331
IN NAME OF

IVAN R. EDWARDS

Surveyed AUG. 13. 1974, by L.H. NUNN