


T.4S., R.2E., W.M.

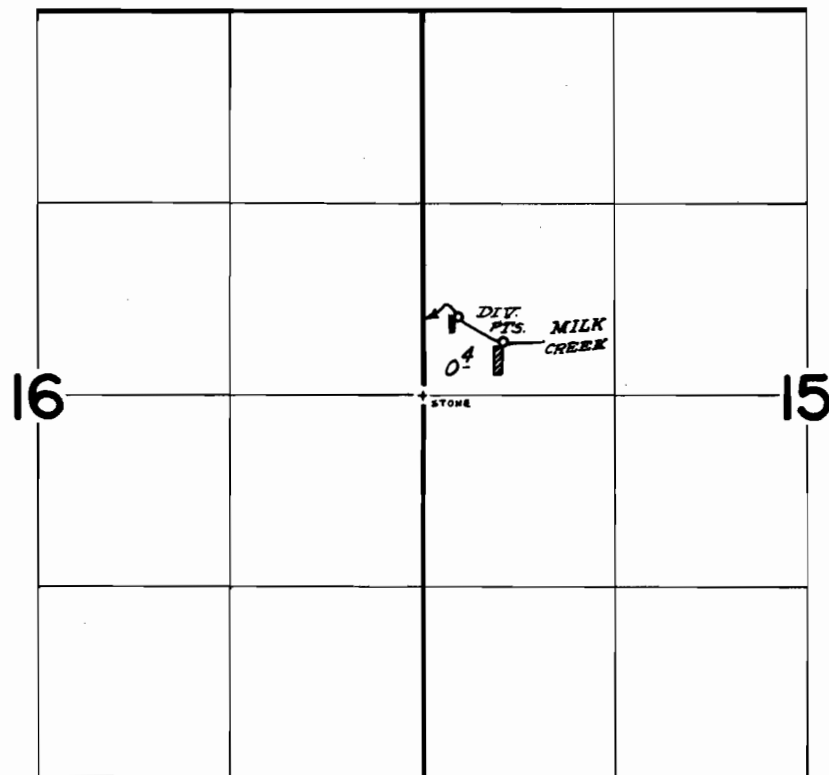

DIV. PTS. LOCATED: 540' N & 240' E; 370' N & 540' E, BOTH FROM W $\frac{1}{4}$ COR. SEC. 15.

FINAL PROOF SURVEY
UNDER

Application No. 48886 Permit No. 35723
IN NAME OF

LEO PAUL OWENS

Surveyed Sept. 4 1974, by D. Noddy