


T. 3S. R. 1W. W.M.

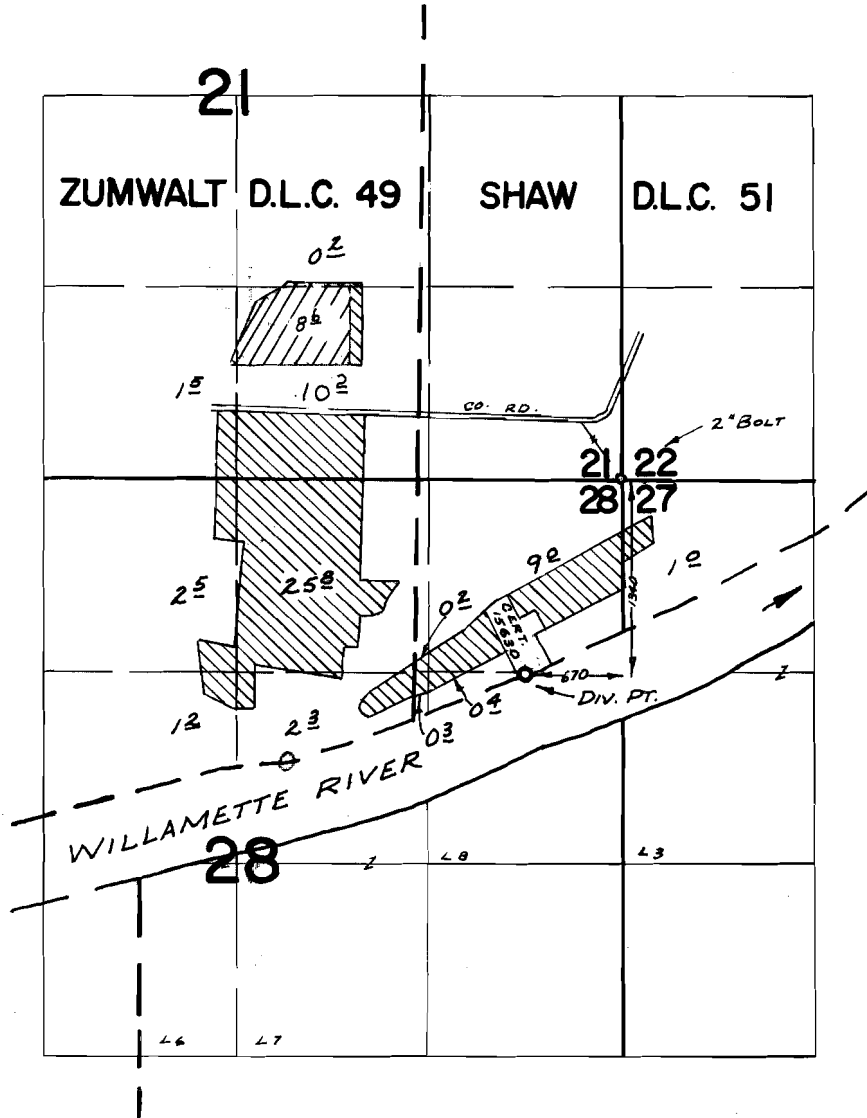

FINAL PROOF SURVEY UNDER

Application No. 48189 Permit No. 36197
43760 32703
 IN NAME OF



HARKSON FARMS, INC.

Surveyed JUNE 2, 1971, by R. MUCKEN