


# T.3S. R.1E. W.M.

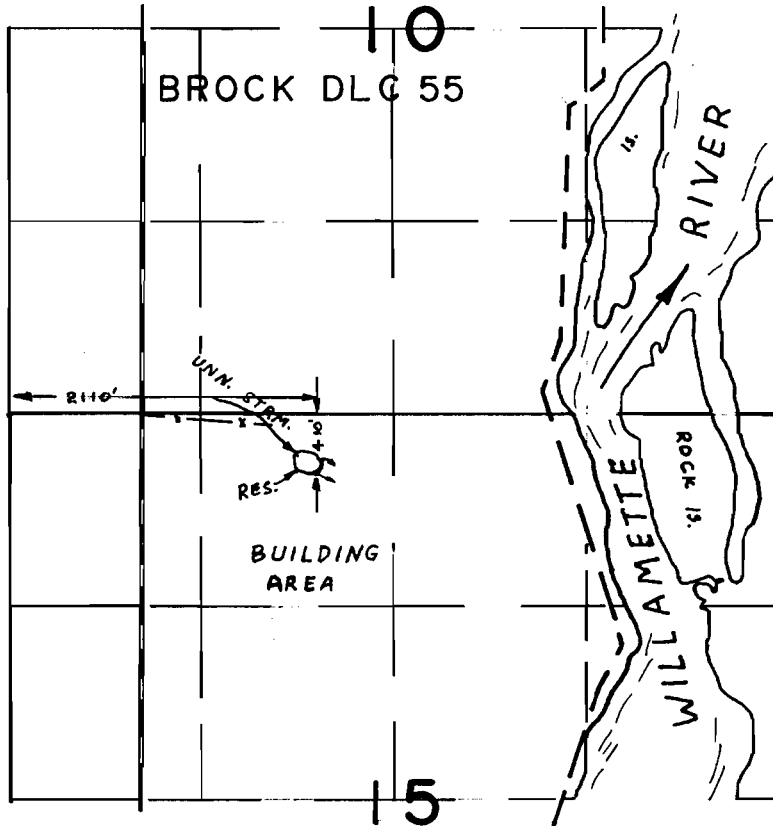

## FINAL PROOF SURVEY UNDER

Application No. 50025 Permit No. 36416  
R-50022 R-5894  
IN NAME OF

NW RANCHES, INC.

Surveyed SEP. 23, 1974, by L.H. NUNN