


T. 3 S. R. 1 E. W. M.

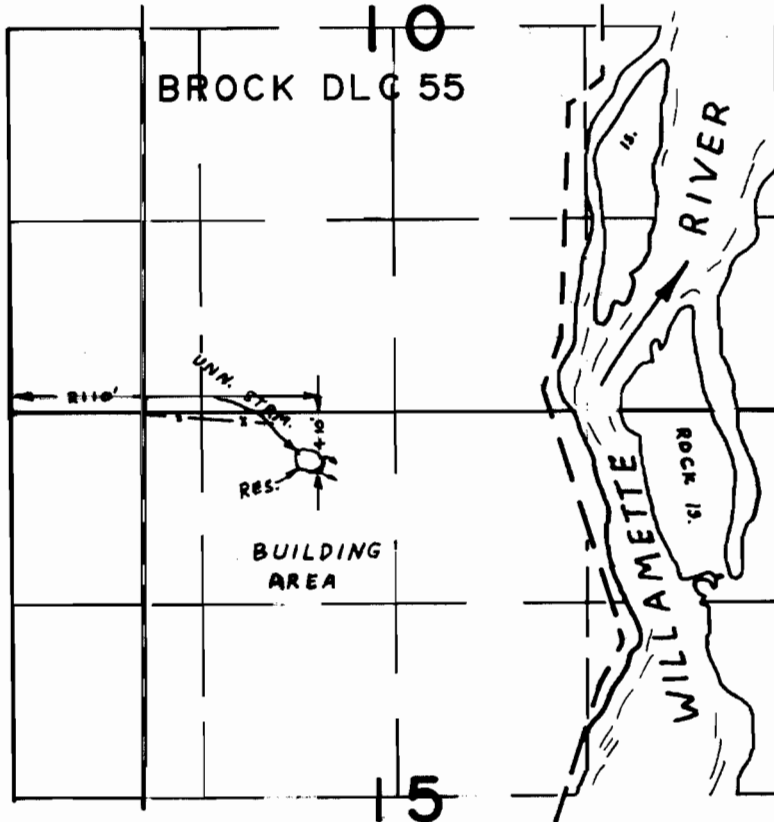

FINAL PROOF SURVEY UNDER

Application No. 50025 Permit No. 36416
R-50022 R-5894
IN NAME OF

NW RANCHES, INC.

Surveyed SEP. 23, 1974, by L.H. NUNN