


T.41S.,R.13W.,W.M.

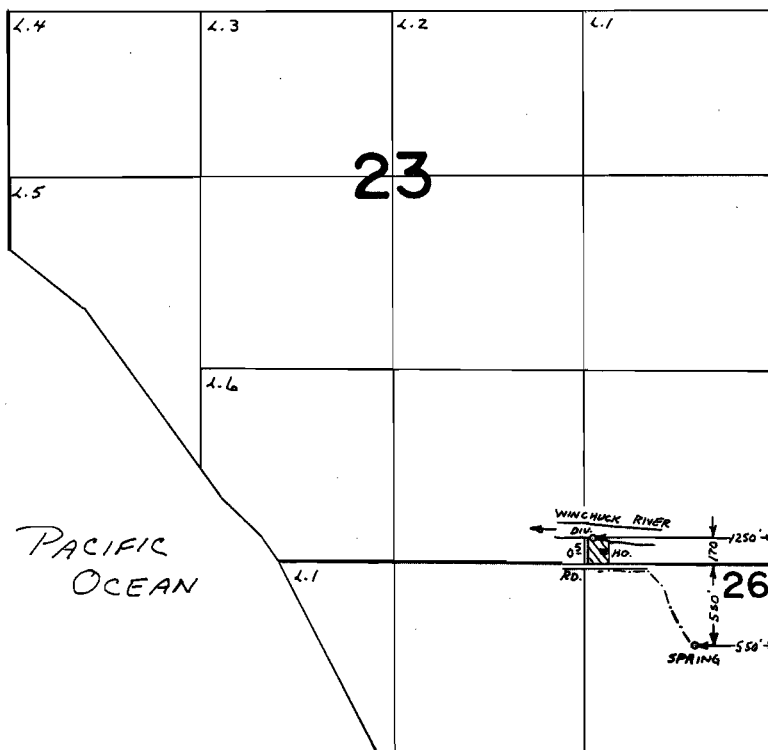

FINAL PROOF SURVEY UNDER

Application No. 52323 Permit No. 37745
IN NAME OF

ARTHUR S. DUHAIME

Surveyed July 19 1975, by L. Toll