


T.22S., R.9W., W.M.

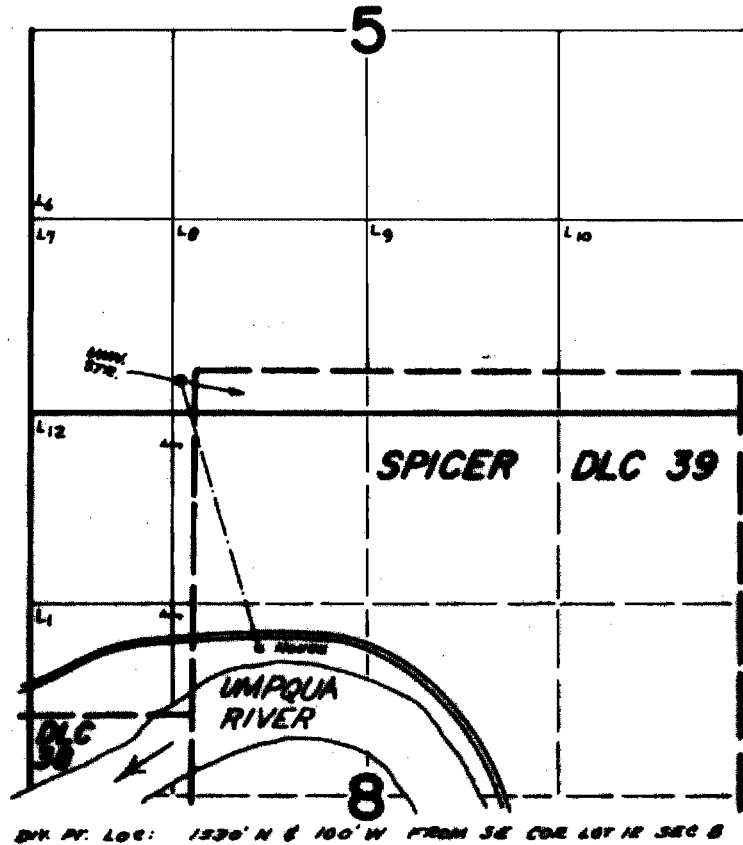

FINAL PROOF SURVEY
UNDER

Application No. 45718 Permit No. 34105
IN NAME OF

YALE A. PARRISH

Surveyed July 24 1975, by D. Morby