


T.25S.,R.8W.,W.M.

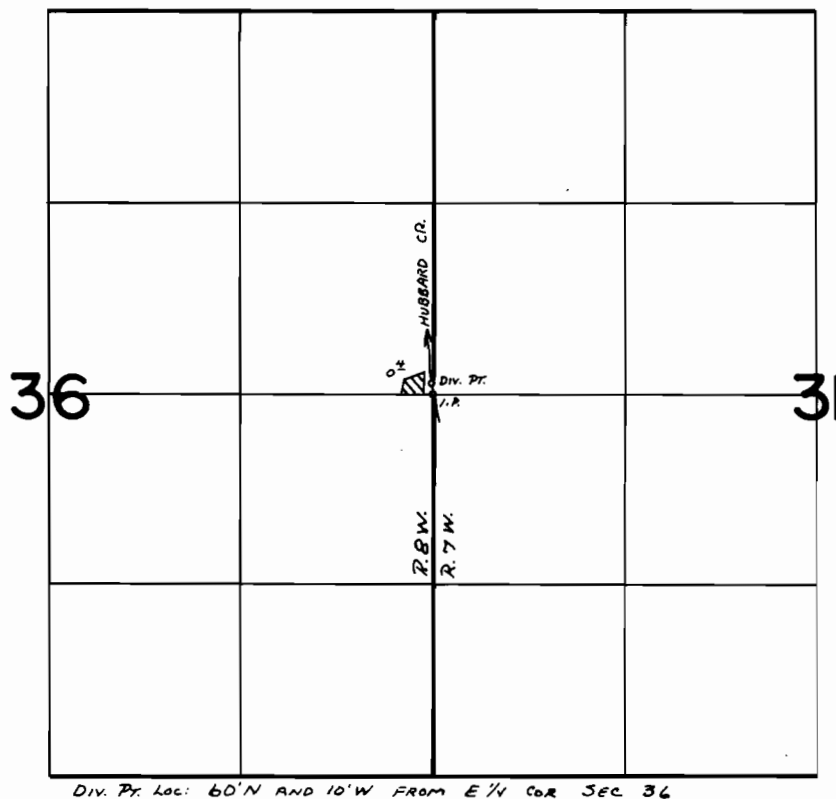

DIV. PT. LOC: 60' N AND 10' W FROM E 1/4 COR SEC 36

FINAL PROOF SURVEY
UNDER

Application No. 50250 Permit No. 37312...
IN NAME OF

CARL T. & KATHY J. TELLER

Surveyed JUNE 5, 1975, by L. E. GORRA