


T.27S. R.6W. W.M.

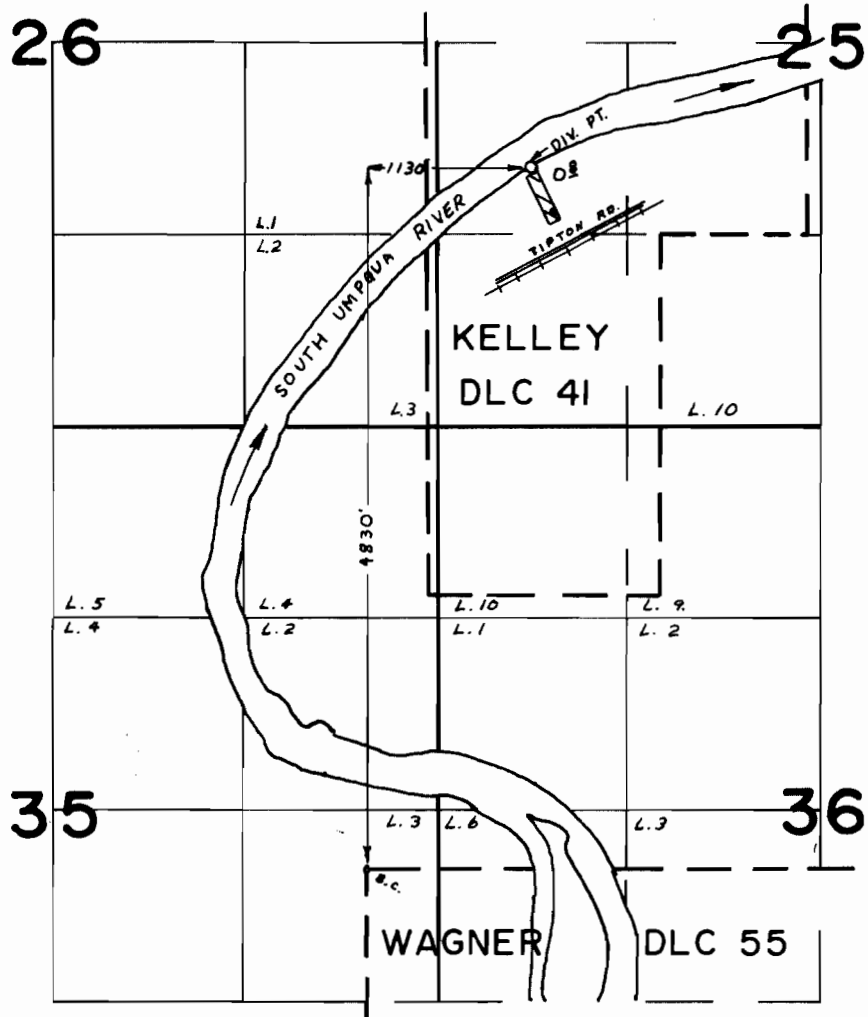

FINAL PROOF SURVEY
UNDER

Application No. 50126 Permit No. 37518
IN NAME OF

CLIFFORD E. & ROBERTA L.
RAADE

Surveyed MAR. 25 1975, by L.H. NUNN