


T.37S. R.2W. W.M.

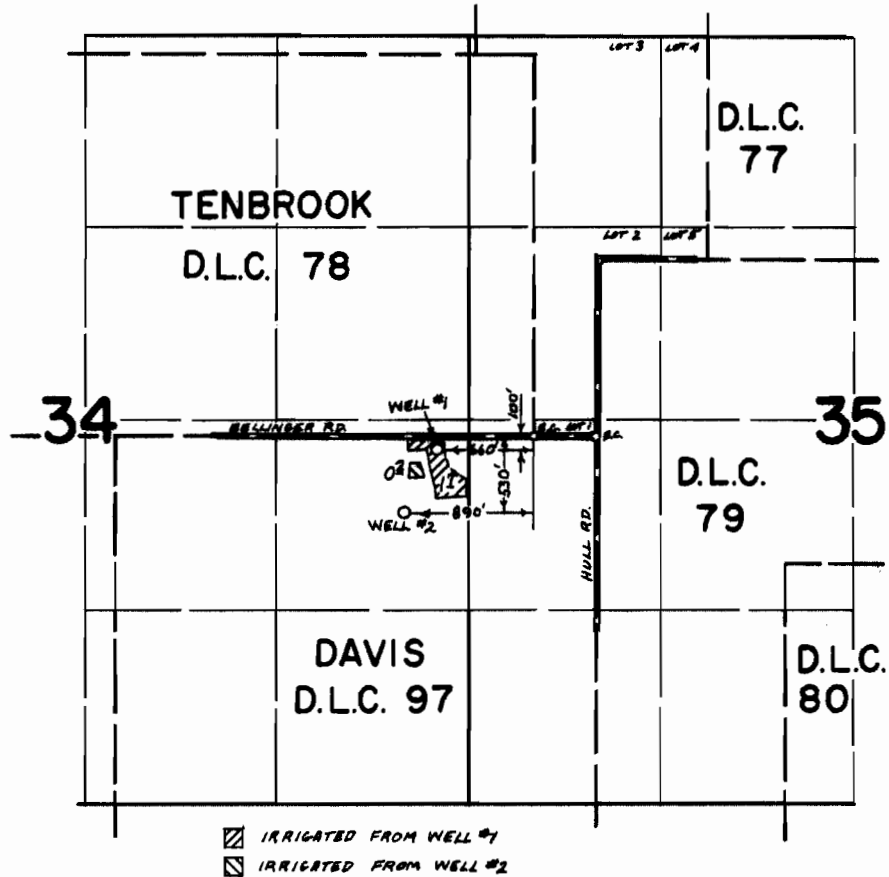

FINAL PROOF SURVEY UNDER

Application No. G-5005 Permit No. G-4723
IN NAME OF

ROBERT AND/OR GLADYS GILMAN

Surveyed NOV. 1 1975, by L. TOLL