


**T.36&37S.R.2E.W.M.**

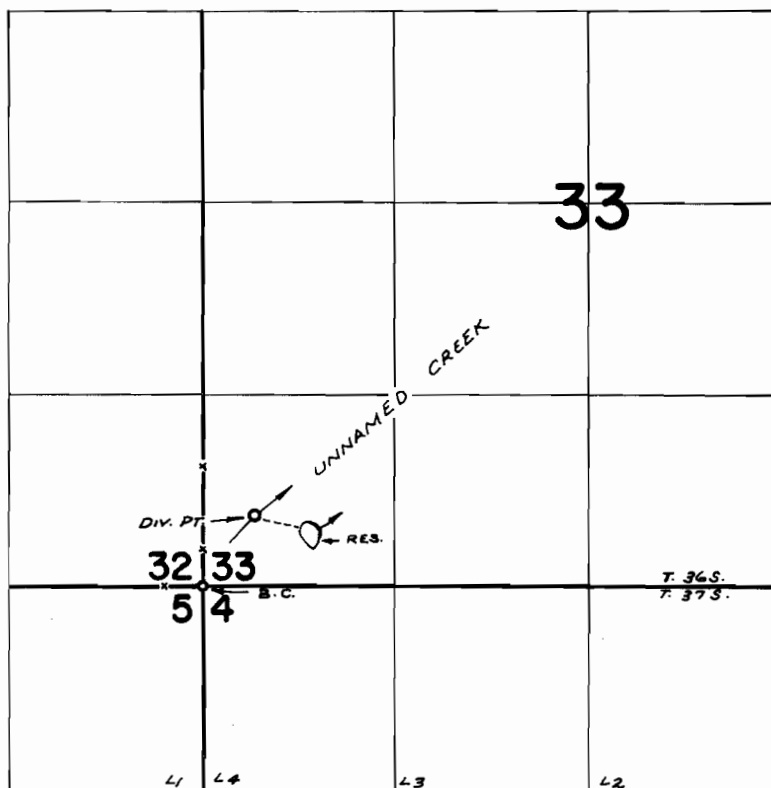

DIV. PT. LOC: 480' N. & 350' E. FROM S.W. COR. SEC. 33

# FINAL PROOF SURVEY

## UNDER

Application No. R-47825 Permit No. R-5793  
IN NAME OF

GEORGE T. McDONALD

Surveyed JUNE 7, 1974, by R. MUCKEN