


T.34S., R.1W., W.M.

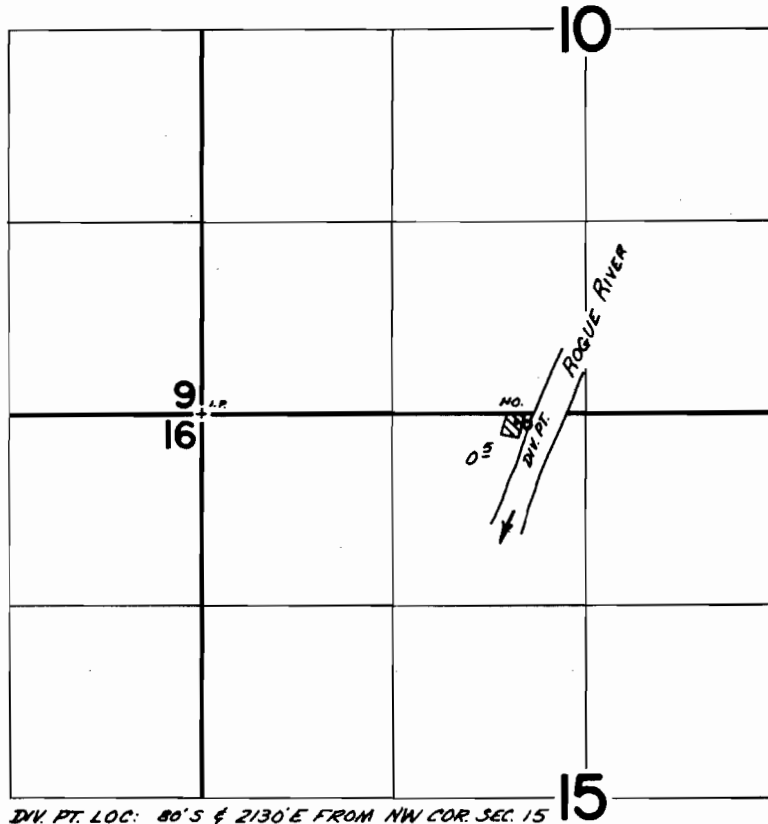

DIV. PT. LOC: 80'S & 2130'E FROM NW COR. SEC. 15

FINAL PROOF SURVEY
UNDER

Application No. 45161 Permit No. 33741
IN NAME OF

ROBERT AND/OR LOIS STRYKER

Surveyed Aug. 19 1975, by D. Norby