


T. 33 S. R. 1 W. W.M.

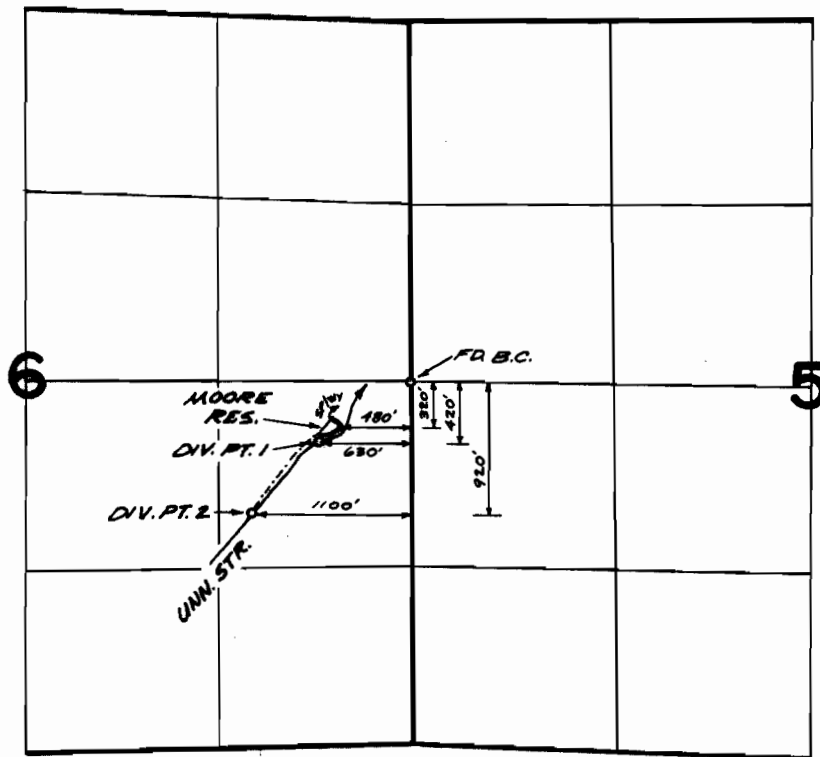

FINAL PROOF SURVEY
UNDER

Application No. R 45229 15230 Permit No. R 5335 53702
IN NAME OF

JESSIE E. THOMAS

Surveyed AUGUST 1, 1974, by D. NORBY