


T. 33 S. R. 1 W. W.M.

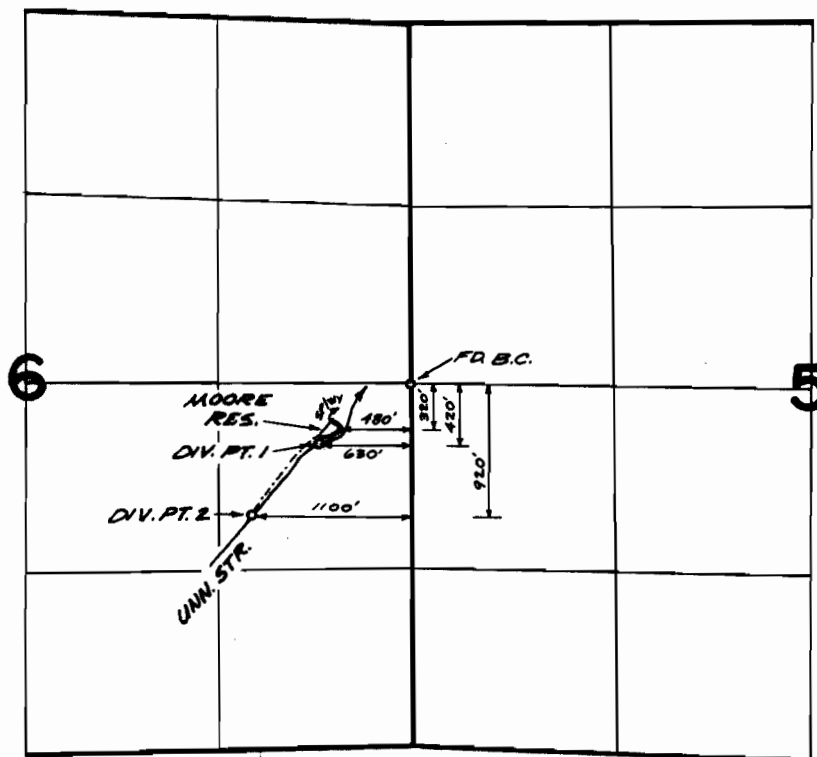

FINAL PROOF SURVEY
UNDER

Application No. *R 45229* ~~15230~~ Permit No. *R 5335* ~~53702~~
IN NAME OF

JESSIE E. THOMAS

Surveyed *AUGUST 1*, 1974, by *D. NORBY*