


T.36 & 37 S. R.2 E. W.M.

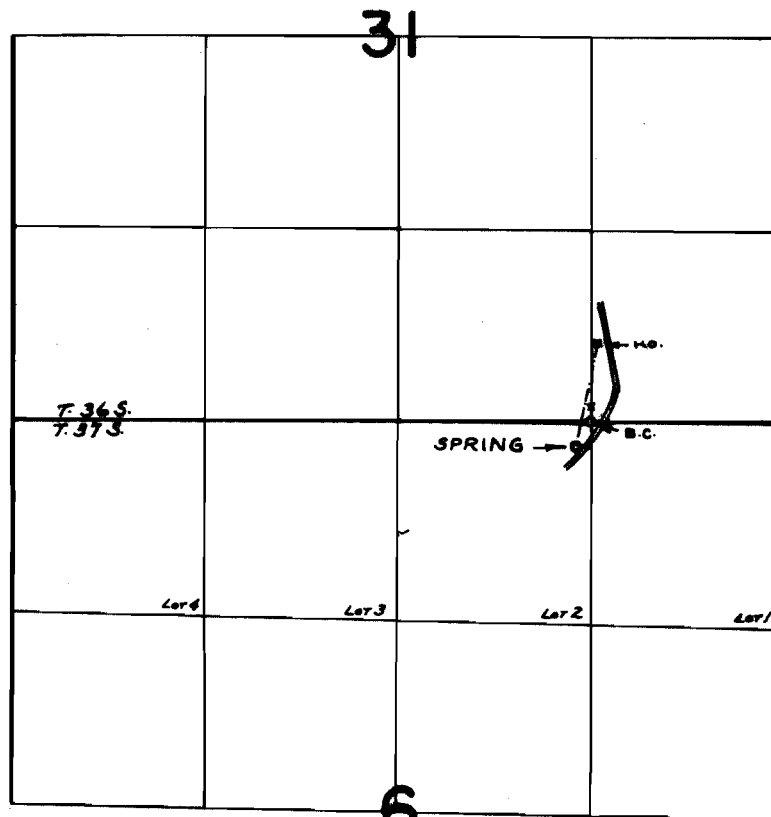

SPRING LOC: 170'S. & 80'W FROM N.E. COR. LOT 2 (NW & NE)
SEC. 6

FINAL PROOF SURVEY
UNDER

Application No. 45542 Permit No. 33970
IN NAME OF

WESLEY E. HOUSEHOLDER

Surveyed JUNE 4, 1974, by R. MUGGEN