


# T.39 S.R.3W.W.M.

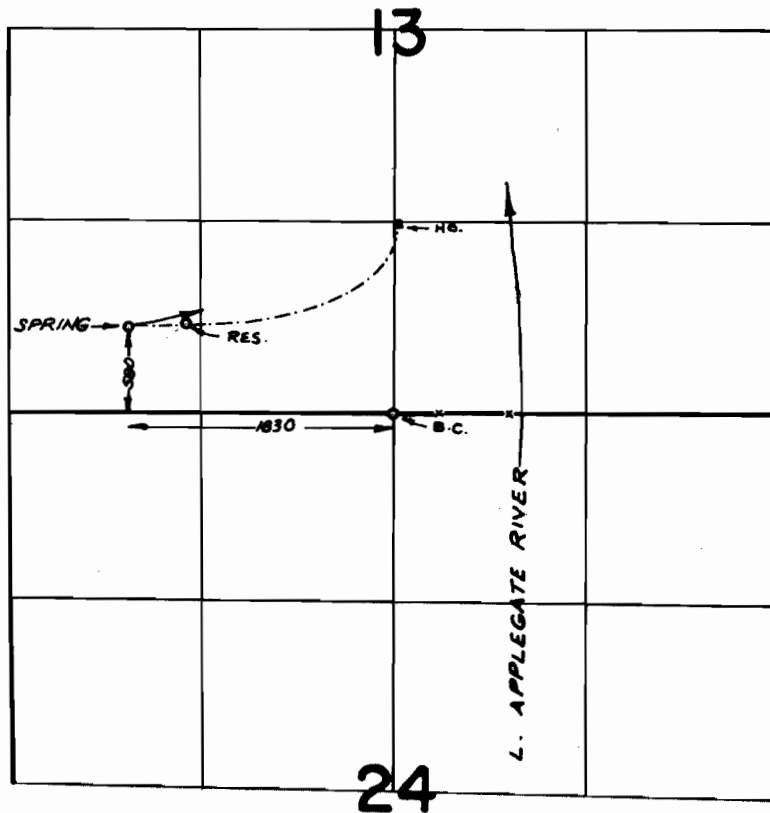

## FINAL PROOF SURVEY UNDER

Application No. 26032... Permit No. 34377...  
IN NAME OF

.....KENT M. OVERHOLT.....

Surveyed SEPT. 24, 1974, by R. MUCKEN