


T.33S.R.2E.W.M.

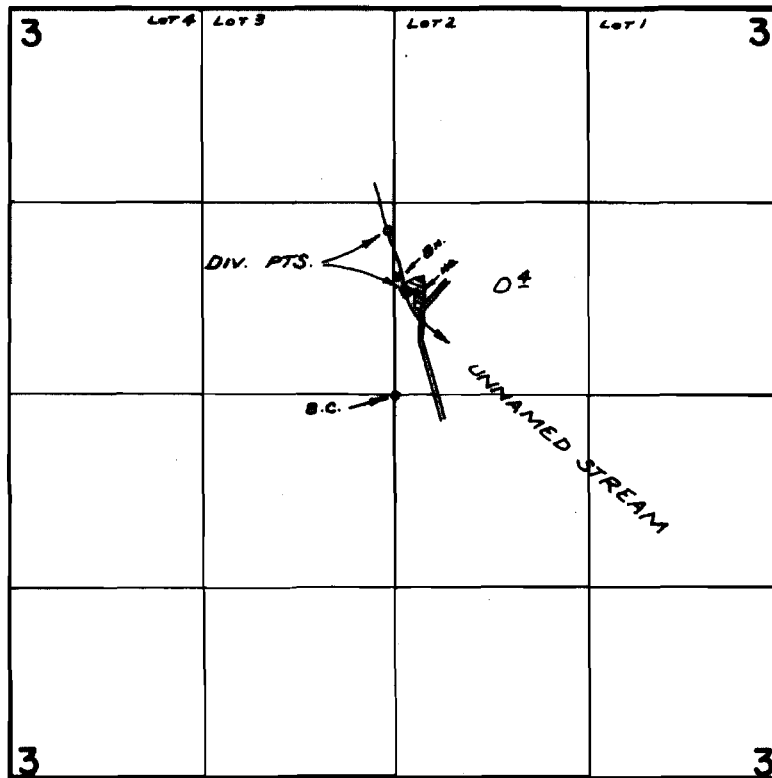

DIV. PTS. LOC: 710' N. & 70' E; 1130' N & 40' W, BOTH FROM CEN. SEC. 3

FINAL PROOF SURVEY
UNDER

Application No. 46/88 Permit No. 345/4
IN NAME OF

DON AND/OR LUELLA A. VAN STEEG

Surveyed JUNE 13, 1974, by R. MUCKEN