


T. 35 S. R. 3 W. W.M.

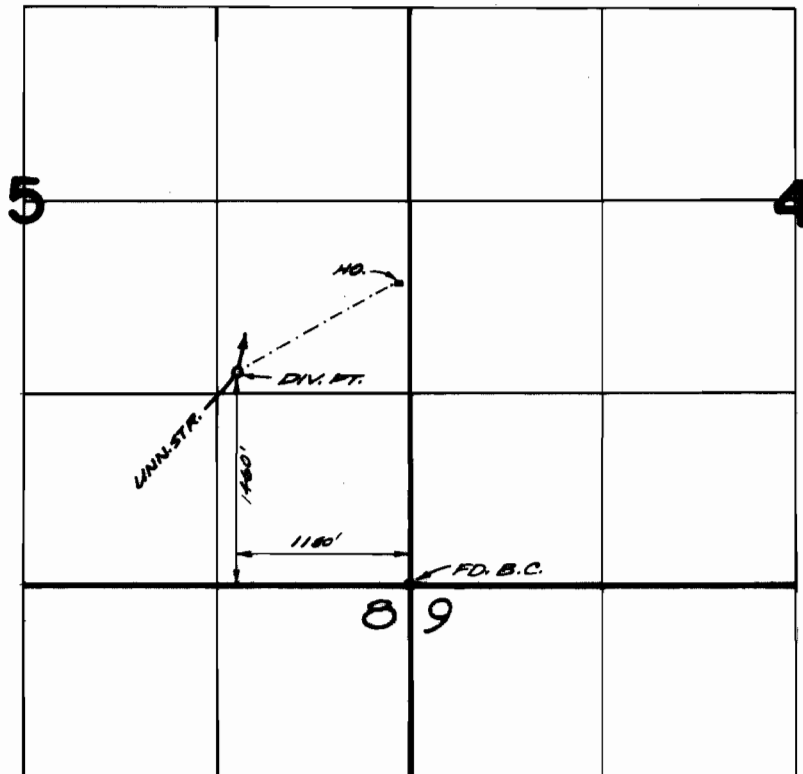

FINAL PROOF SURVEY
UNDER

Application No. 46580 Permit No. 34811

IN NAME OF

ESTATE OF

SAMUEL A. BLACKMON

Surveyed July 26 1974, by D. NORBY