


T.33S.R.2E.W.M.

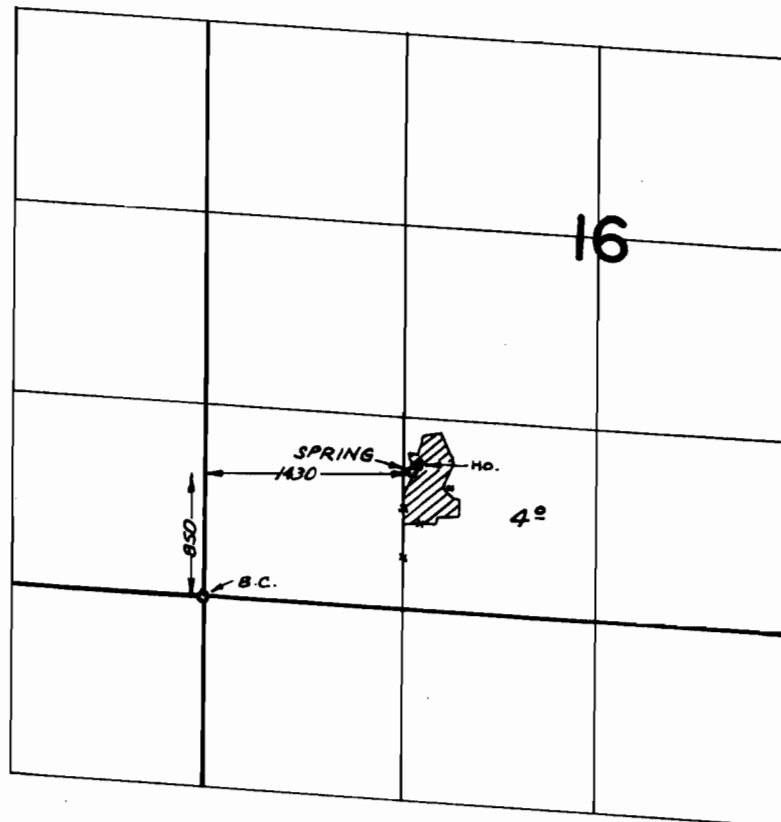

FINAL PROOF SURVEY
UNDER

Application No. 46780 Permit No. 34931....
IN NAME OF

.....ERNEST B. HUETER.....

Surveyed JUNE 11, 1914, by R. MUCKEN