


T.40S.R.3W.W.M.

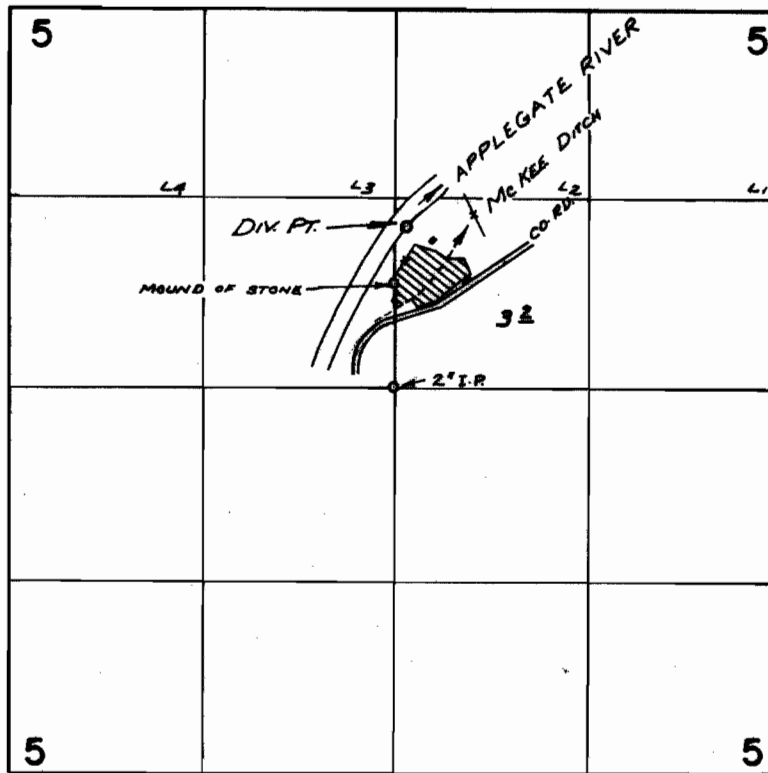

DIV. PT. LOC: 1110'N. & 80'E. FROM CEN. SEC. 5

FINAL PROOF SURVEY
UNDER

Application No. 47604 Permit No. 35633
IN NAME OF

JAMES E. & MARY E. ECK

Surveyed SEPT. 23, 1974, by R. MUCKEN