


T. 33 S. R. 1 W. W.M.

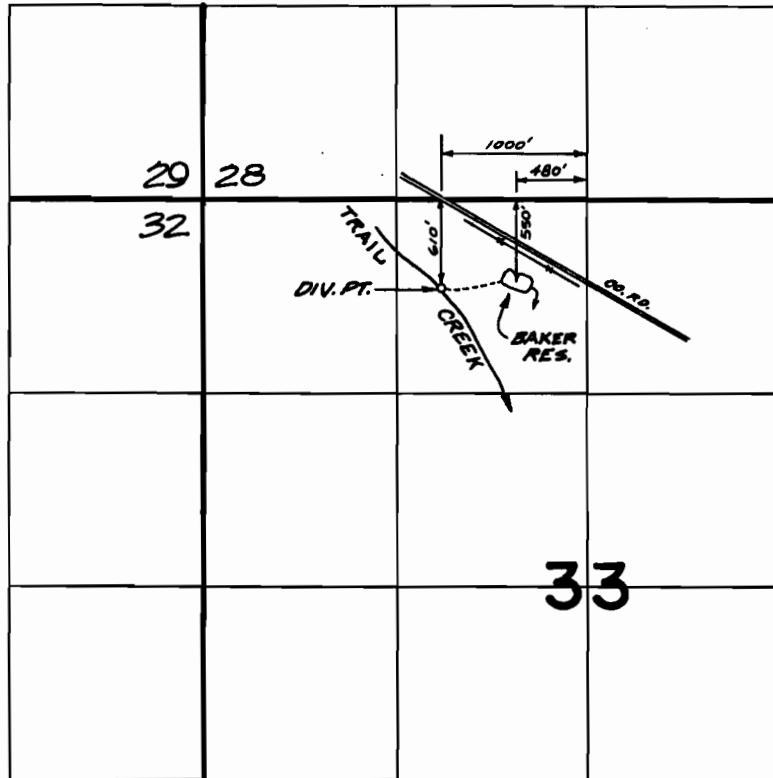

FINAL PROOF SURVEY UNDER

Application No. ^{R 48368} 48369 Permit No. ^{R 5876} 36314
IN NAME OF

ROBERT M. BAKER

Surveyed AUGUST 1 1974, by P. NORBY