


T. 33 S. R.1 W. W.M.

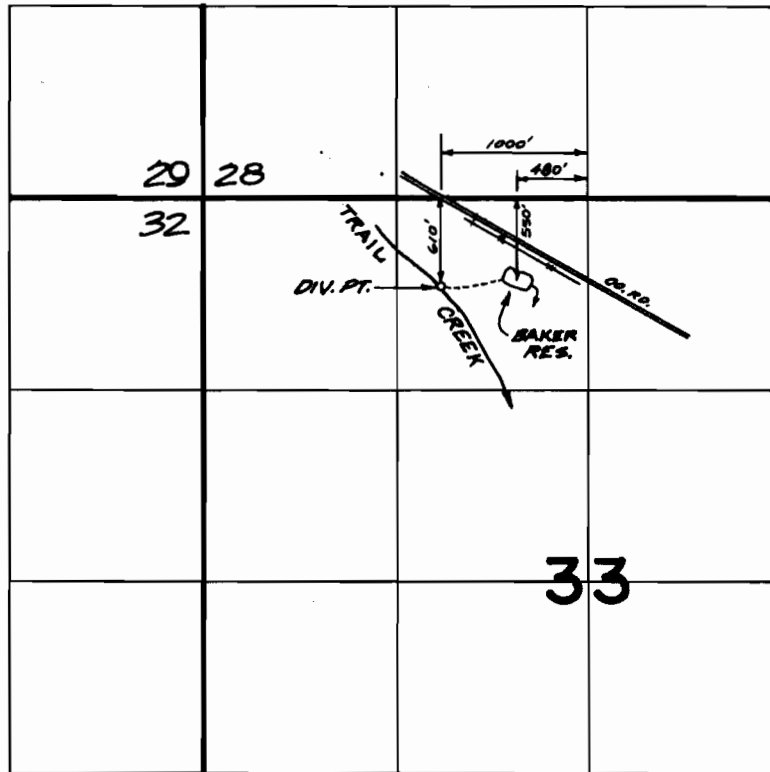

FINAL PROOF SURVEY UNDER

Application No. ^{R 48368} ~~48369~~ Permit No. ^{R 5876} ~~36314~~
IN NAME OF

ROBERT M. BAKER

Surveyed AUGUST 1 1974, by R. NORBY