


# T.12S.,R.15E.,W.M.

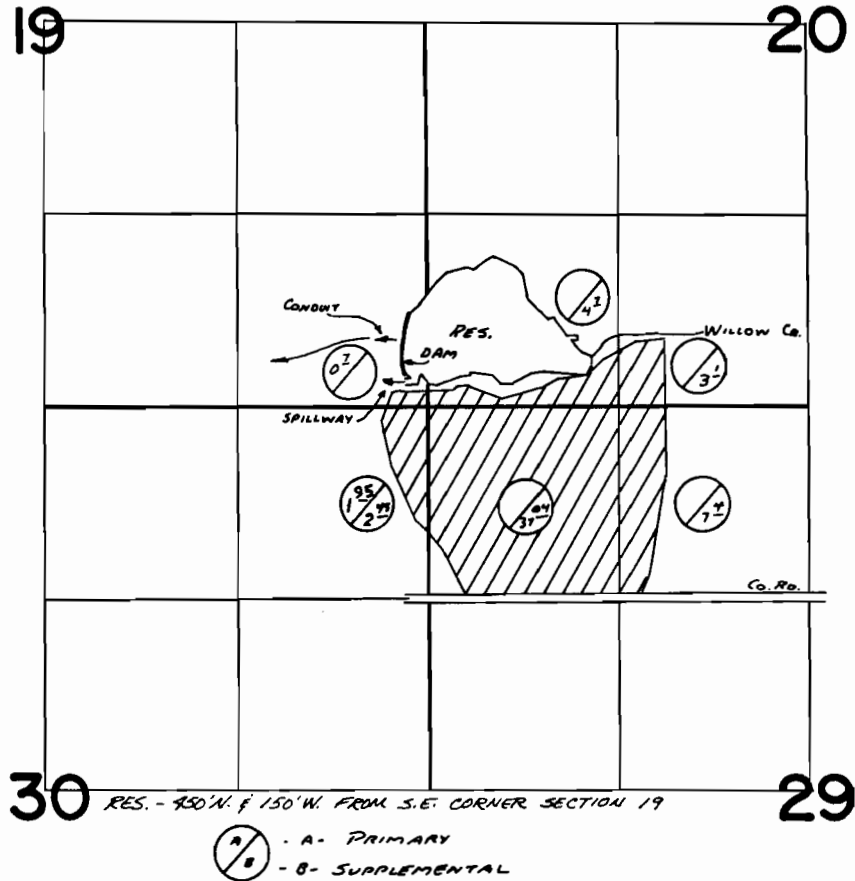

## FINAL PROOF SURVEY UNDER

R-44164                      R-5356  
 Application No. 44165... Permit No. 33849...  
 IN NAME OF

MORROW BROS., INC.

Surveyed JUNE 13, 1975, by L. E. GONLO