


T.35S. R.7W. W.M.

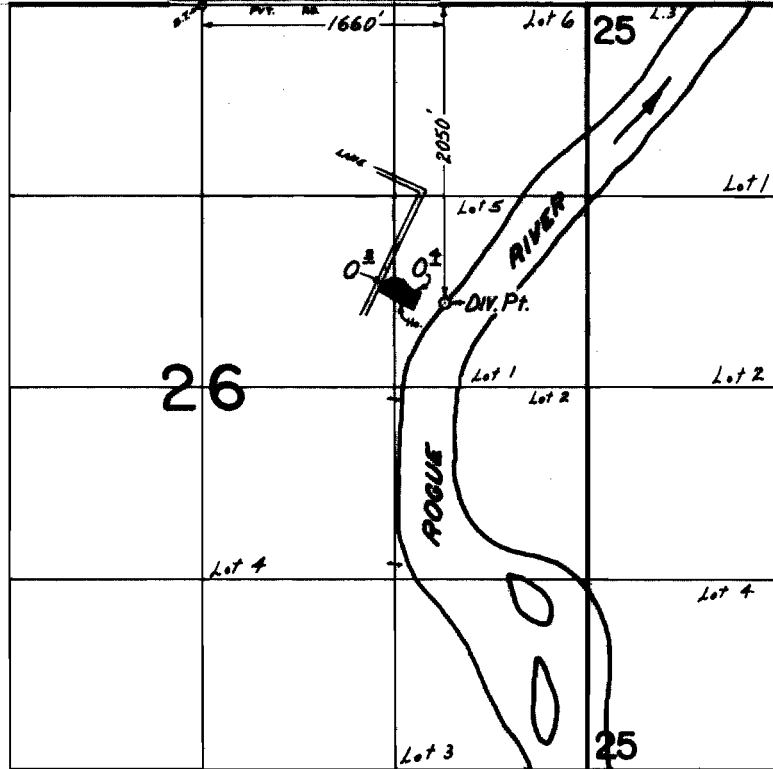

FINAL PROOF SURVEY
UNDER

Application No. 46201 Permit No. 34519
IN NAME OF

ALLEN R. SPOTTS

Surveyed MAY 16, 1974, by L.E. GOULD