


T.38S.,R.48&5W.,W.M.

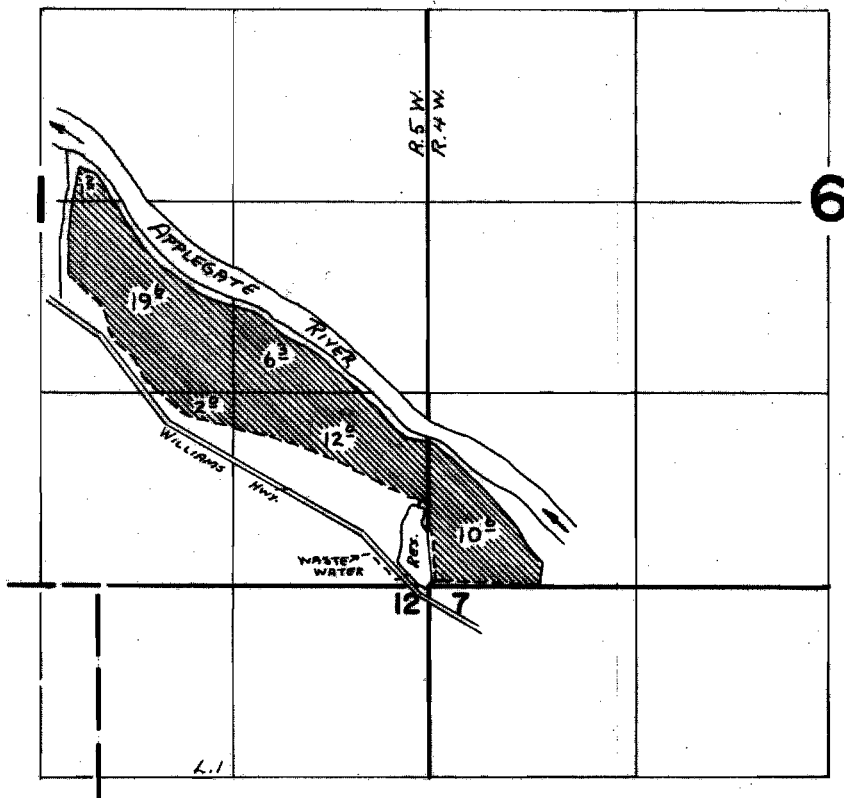

FINAL PROOF SURVEY
UNDER

R-47599 R-5734
Application No. 47600 Permit No. 35629
IN NAME OF

ESTATE OF ELERY STONE

Surveyed SEPT. 17 1974, by L. TOLL